

**SURVEY &
REMONUMENTATION**

LIBER **14833** PG **119**

94 19336

MAY - 1 1995

LAND CORNER RECORDATION CERTIFICATE
Filing Requirement of Act 74, Mich. P.A. 1970

For corners in
Oakland

COMMISSION

OK - T. SMITH

(County)	Located In:	Corner Code #
	5N 11E	J-5
1. Public Land Survey	T _____ R _____	_____
	T _____ R _____	_____
	T _____ R _____	_____
	T _____ R _____	_____
2. Property Controlling in Section	S _____ T _____ R _____	_____
	S _____ T _____ R _____	_____
3. Miscellaneous Property in Sec.	S _____ T _____ R _____	_____
	S _____ T _____ R _____	_____

\$ 7.00 MISCELLANEOUS RECORDING
\$ 2.00 REMONUMENTATION
15 JUL 94 7:28 A.M. RECEIPT# 1A
PAID RECORDED - OAKLAND COUNTY
LYNN D. ALLEN, CLERK REGISTER OF DEEDS
ACT 345, P.A. 1990

APPROVED ON: 2-2-94
OAKLAND COUNTY REMONUMENTATION
P&R GROUP COMMITTEE

Register of Deeds Stamp & File Number

4. Lot No. _____, Recorded Plat _____
5. Private Claims _____

	A	B	C	D	E	F	G	H	I	J	K	L	I
2	6		5		4		3		2		1		
3													
4	7		8		9		10		11		12		
5													
6	18		17		16		15		14		13		
7													
8	19		20		21		22		23		24		
9													
10	30		29		28		27		26		25		
11													
12	31		32		33		34		35		36		
13													

I, Bruce Antcliff in a field survey on November 10, 1993, do hereby certify that under requirements of P.A. 74, Michigan P.A. of 1970, the corner points mentioned in lines 1 and 2 above were in conformance with regulations and rules therefore as required in the current manual of survey instructions of the United States Department of the Interior, Bureau of Land Management or by a decree of a Court of Law and/or that the corner points mentioned in lines 3, 4 and 5 above were in conformance with the rules of the Michigan Board of Land Surveyors or by a Decree of a Court of Law; established, re-established, monumented, re-monumented, recovered, found as expressed below:

NOTE: Not more than 4 corners, all in the same town and range, may be recorded on this certificate.

A. Description of original monument and accessories and/or subsequent restoration:

J-5 GLO Post	Survey L. 12759, P. 031 Find 1" Iron Pipe S 6.11' NW E Face 26" Oak W 19.55' NW N Face 7" Oak N 12.67' NW W Face 7" Oak E 14.87' N/W S Face 7" Oak	L.C.R.C. L. 8383, P. 21 (5/10/82) 1" Iron Pipe N 20 E - 12.50' Nail E Face 6" Tree E 14.95' Nail S Face Twin 6" Tree S 6.65' Nail E Face Twin 24" Oak	L.C.R.C. L. 9169, P. 206 (11/9/84) 1" Iron Pipe at Anchor Post NNE - 12.65' Nail & Tag #17623 8" Elm WSW - 19.51' Nail & Tag #17623 8" Elm ENE - 14.84' Nail & Tag #17623 Twin 8" Oak S - 6.10' Nail & Tag #17623 Twin 28" Oak
--------------	---	---	---

B. Description of corner evidence found and/or method applied in restoring or reestablishing corner:

J-5 Found 1" iron pipe with spike in center at angle point in new barbed wire fences.
Checks the following witnesses:


Survey L. 12759, P. 031 W 19.55' NW N Face 7" Oak E 14.87' N/W S Face 7" Oak	L.C.R.C. L. 8383, P. 21 E 14.95' Nail S Face Twin 6" tree	L.C.R.C. L. 9169, P. 206 NNE 12.65' Nail & Tag #17623 8" Elm WSW 19.51' Nail & Tag #17623 8" Elm S 6.10' Nail & Tag #17623 Twin 28" Oak
--	--	--

C. Description of monument for corner and accessories established to perpetuate locating the position of the corner:

J-3 The selected location is accepted by the Contractor and is generally accepted by professional surveyors as the best available evidence of the position of the original corner.

Set concrete monument with standard Oakland County cap.

- P.K. Nail and Brass Tag in NW Face Twin 28" Oak - S 25° W - 5.93'
- P.K. Nail and Brass Tag in N Face 8" Elm - West - 19.65'
- P.K. Nail and Brass Tag in NW Face 8" Elm - N 31° E - 12.83'
- P.K. Nail and Brass Tag in W Face 12" Oak - N 05° E - 50.19'

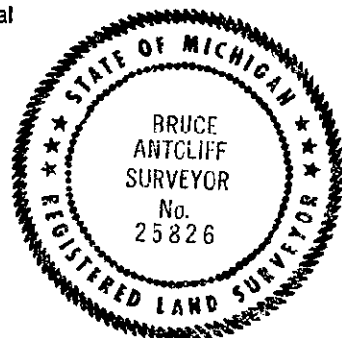

Signed by Bruce Antcliff
Surveyor's Michigan License No. 25826

Date 7-11-94