

SURVEY & REMONUMENTATION

LIBER 15234 pc 538

FEB 29 50 1998

MAY - 1 1995

LAND CORNER RECORDATION CERTIFICATE \$ 7.00 MISCELLANEOUS RECORDING
 Filing Requirement of Act 74, Mich. P.A. 1970 \$ 2.00 REMONUMENTATION

For corners in **COMMISSION**


2 FEB 95 7:23 A.M. RECEIPT# 2B
 PAID RECORDED - OAKLAND COUNTY
 LYNN D. ALLEN, CLERK/REGISTER OF DEEDS

OK - T. SMITH

Compliance with
 ACT 345, P.A. 1990

APPROVED ON: 11-30-94
 OAKLAND COUNTY REMONUMENTATION
 PEER GROUP COMMITTEE
 Register of Deeds Stamp & File Number

For corners in	Located in:	Addison Township	Corner Code #
<u>Oakland</u> (County)			
1. Public Land Survey	T <u>5N</u> R <u>11E</u>		<u>J-9</u>
	T _____ R _____		_____
	T _____ R _____		_____
	T _____ R _____		_____
2. Property Controlling in Section	S _____ T _____ R _____		_____
	S _____ T _____ R _____		_____
3. Miscellaneous Property in Sec.	S _____ T _____ R _____		_____
	S _____ T _____ R _____		_____
4. Lot No. _____, Recorded Plat _____			
5. Private Claims _____			

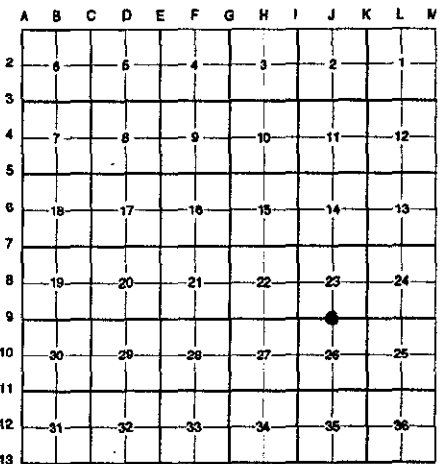

I, Randy Kolehouse, in a field survey on July 21 19 94, do hereby certify that under requirements of P.A. 74 Michigan P.A. of 1970, the corner points mentioned in lines 1 and 2 above were in conformance with regulations and rules therefore as required in the current manual of survey instructions of the United States Department of the interior, Bureau of Land Management or by a decree of a Court of Law and/or that the corner points mentioned in lines 3, 4 and 5 above were in conformance with the rules of the Michigan Board of Land Surveyors or by a Decree of a Court of Law; established, re-established, monumented, re-monumented, recovered, found as expressed below:

NOTE: Not more than 4 corners, all in the same town and range, may be recorded on this certificate.

A. Description of original monument and accessories and/or subsequent restoration:

J-9 Per G.L.O. notes, J. Wampler set a post in 1817.

O.C.R.C. 1962 NE 67.75' Nail in 24' Oak	L.C.R.C. L. 6575 P. 114 1975 3/4" Iron Pipe	L.C.R.C. L. 7283 P. 210 1978 3/4" Pipe	Record Survey L.9169 P. 228 (1985) 1/2" Iron by "T" Iron
NW 62.2' Nail in 18" Walnut	N 27° E 68.72' 15" Maple	N 25° W 78.40' 24" Maple	P.K. in 14" Maple NNE 66.25'
SE 47.5' Nail in 18" Maple	N 14° W 78.15' 26" Maple	N 50° E 51.08' Sign Post	P.K. in 30" Maple ESE 71.15'
	N 55° E 51.02' St. Sign Post	S 70° E 75.45' 27" Maple	Nail & Cap (17623) in 30" Maple NNW 79.73'

B. Description of corner evidence found and/or method applied in restoring or reestablishing corner:

J-9 Found 3/4" pipe 7' East of the West line of Texter Road running North (gravel) and 11' North of the South line of Mack Road (gravel) running E-W and checked the following witnesses.

L.C.R.C. L. 6575 P. 114 1975 N 29° E 68.85' Nail in E Side 24" Maple	L.C.R.C. L. 7283 P. 210 1978 N 57° E 51.77' SE Face of Sign Post
--	---


Kobs Measures 2745.17' to J-8
 Kobs Measures 2837.70' to K-9

C. Description of monument for corner and accessories established to perpetuate locating the position of the corner:

J-9 Set a 5/8" rebar with brass cap stamped "Oakland County Remonumentation P.S. #25854" in place of found 3/4" pipe.

- PK Nail & Tag Stamped "Oakland Co. Remonumentation P.S. #25854" in S Side 17" Maple N 65° W 93.17'
- PK Nail & Tag Stamped "Oakland Co. Remonumentation P.S. #25854" in E Side 28" Oak N 25° E 87.21'
- PK Nail & Tag Stamped "Oakland Co. Remonumentation P.S. #25854" in E Side 24" Maple N 29° E 68.85' SE Face of Sign Post N 57° E 51.77'
- PK Nail & Tag Stamped "Oakland Co. Remonumentation P.S. #25854" in S Side 14" Locust N 74° E 93.94'
- PK Nail & Tag Stamped "Oakland Co. Remonumentation P.S. #25854" in SE Side 12" Locust S 59° W 40.14'

The selected location is accepted by the Contractor and is generally accepted by professional surveyors as the best available evidence of the position of the original corner.

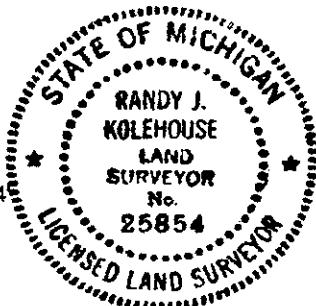

Signed by Randy J. Kolehouse Date 12/23/94
 Surveyor's Michigan License No. 25854