

SURVEY &
REMONUMENTATION

94 193371

LIBER 14833 PG 127

Land / Cor
MAY - 1 1995

LAND CORNER RECORDATION CERTIFICATE
Filing Requirement of Act 74, Mich. P.A. 1970

For corners in
Oakland
COMMISSION

OK - T. SMITH

(County)	Located In:		Corner Code #
	5N	11E	
1. Public Land Survey	T	R	L-5
	T	R	
	T	R	
	T	R	
2. Property Controlling in Section	S	R	
	S	R	
3. Miscellaneous Property in Sec.	S	R	
	S	R	

\$ 7.00 MISCELLANEOUS RECORDING
\$ 2.00 REMONUMENTATION
15 JUL 94 7:29 A.M. RECEIPT # 1A
PAID RECORDED - OAKLAND COUNTY
LYNN D. ALLEN, CLERK/REGISTER OF DEEDS
ACT 345, P.A. 1990

APPROVED ON: 2-2-94
OAKLAND COUNTY REMONUMENTATION
Register of Deeds Stamp & File Number

4. Lot No. _____, Recorded Plat _____
5. Private Claims _____

	A	B	C	D	E	F	G	H	I	J	K	L	A
2	6	5	4	3	2	1							
3													
4	7	8	9	10	11	12							
5													
6	18	17	16	15	14	13							
7													
8	19	20	21	22	23	24							
9													
10	30	29	28	27	26	25							
11													
12	31	32	33	34	35	36							
13													

Bruce Antcliff November 11 93

I, _____, in a field survey on _____, 19_____, do hereby certify that under requirements of P.A. 74, Michigan P.A. of 1970, the corner points mentioned in lines 1 and 2 above were in conformance with regulations and rules therefore as required in the current manual of survey instructions of the United States Department of the Interior, Bureau of Land Management or by a decree of a Court of Law and/or that the corner points mentioned in lines 3, 4 and 5 above were in conformance with the rules of the Michigan Board of Land Surveyors or by a Decree of a Court of Law; established, re-established, monumented, re-monumented, recovered, found as expressed below:

NOTE: Not more than 4 corners, all in the same town and range, may be recorded on this certificate.

A. Description of original monument and accessories and/or subsequent restoration:

L-5	GLO Post	L.C.R.C. L. 9418, P. 92 (1986) 1/2" Iron PK in 6" Oak - NNW - 44.72' PK in 26" Oak - NNE - 64.88' PK in 14" Oak - ENE - 14.85' PK in 36" Oak - S - 87.31'	Survey L. 9418, P. 87 (1986) Meas 2672.94 to NE Corner Sec. 13 Meas 2680.92 to NW Corner Sec. 13 Same Witnesses as L.C.R.C. Recorded L. 9418, P. 92
-----	-------------	--	---

B. Description of corner evidence found and/or method applied in restoring or reestablishing corner:

L-5 Found 1/2" rebar in fence line running East & West
Checks the following witnesses:


L.C.R.C. L. 9418, P. 92
14" Oak - ENE - 14.85'
38" Oak - S - 87.31'

C. Description of monument for corner and accessories established to perpetuate locating the position of the corner:

L-5 The selected location is accepted by the Contractor and is generally accepted by professional surveyors as the best available evidence of the position of the original corner.

Set concrete monument with standard Oakland County cap.

P.K. Nail and Brass Tag in E Face 30" Oak - N 10° E - 72.31"
P.K. Nail and Brass Tag in N. Face 16" Oak - N 70° E - 14.92"
P.K. Nail and Brass Tag in S Face 14" Poplar - West - 5.06"
P.K. Nail and Brass Tag in W Face 38" Oak - South - 87.39"

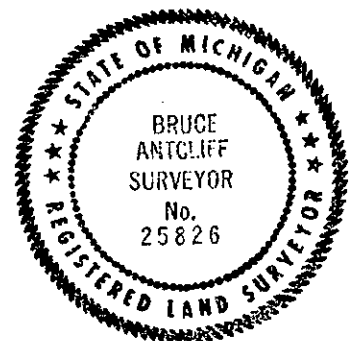

Signed by Bruce Antcliff
Surveyor's Michigan License No. 25826

Date 7-11-94