

MAY 16 1996

LIBER 15913 PG 758

COMMISSION

LAND CORNER RECORDATION CERTIFICATE
Filing Requirement of Act 74, Mich. P.A. 1970

Compliance with
ACT 345, P.A. 1990

APPROVED ON: 6-19-95 T.S.
OAKLAND COUNTY REMONUMENTATION
PEER GROUP COMMITTEE

For corners in

<u>Oakland</u> (County)	Located in:	Addison Township	Corner Code # M-1
1. Public Land Survey	T <u>5N</u>	R <u>11E</u>	<u>M-1</u>
	T _____	R _____	_____
	T _____	R _____	_____
	T _____	R _____	_____
2. Property Controlling in Section	S _____	T _____	R _____
	S _____	T _____	R _____
3. Miscellaneous Property in Sec.	S _____	T _____	R _____
	S _____	T _____	R _____
4. Lot No. _____, Recorded Plat _____			
5. Private Claims _____			

\$ 7.00 MISCELLANEOUS RECORDING
\$ 2.00 REMONUMENTATION
29 DEC 95 9:02 A.M. RECEIPT# 44A
PAID RECORDED - OAKLAND COUNTY
LYNN D. ALLEN, CLERK/REGISTER OF DEEDS

Register of Deeds Stamp & File Number

I, Randy Kolehouse, in a field survey on May 5, 19 95, do hereby certify that under requirements of P.A. 74 Michigan P.A. of 1970, the corner points mentioned in lines 1 and 2 above were in conformance with regulations and rules therefore as required in the current manual of survey instructions of the United States Department of the interior, Bureau of Land Management or by a decree of a Court of Law and/or that the corner points mentioned in lines 3, 4 and 5 above were in conformance with the rules of the Michigan Board of Land Surveyors or by a Decree of a Court of Law; established, re-established, monumented, re-monumented, recovered, found as expressed below:

NOTE: Not more than 4 corners, all in the same town and range, may be recorded on this certificate.

A. Description of original monument and accessories and/or subsequent restoration:

M-1	1817	Wampler	G.L.O.
	1933	O.C.R.C.	
	1977	Kobs	Cert. Survey L. 2811 P. 751
	1993	Money	L.C.R.C. L. 5 P. 7

Set Post
Sec. Cor. #1
1/2" Iron Bar

B. Description of corner evidence found and/or method applied in restoring or reestablishing corner:

M-1 Found 2" brass disc. "Lapeer Co. Remonumentation #30092" at the C/L of Bordman Road 10' East ± of the C/L of Bishop Road (gravel) which agrees with Cert. Survey L. 2811 P. 751 and Lapeer County Remon. Cert. L.C.R.C. L. 5 P. 7. Did not find stone shown in 1933 O.C.R.C. records.

Co. Surveyor Witnesses for Addison Twp. #1
NW'ly Nail in 18" Maple 84.05'
NW'ly Nail in Root 20" Maple 136.65'

Money L.C.R.C. L. 5 P. 7 1993
N 70° W 137.81' Lapeer Tag/Nail in the S Root of 36" Maple
N 25° W 84.11' Lapeer Tag/Nail in the E Face of 30" Maple
N 30° E 67.36' Lapeer Tag/Nail in the W Face Util. Pole
S 30° E 46.02' Lapeer Tag/Nail in the SW Face 15" W Cherry

C. Description of monument for corner and accessories established to perpetuate locating the position of the corner:

M-1 Corner is common to Lapeer & Macomb Counties. I left existing 2" brass cap as is.

PK Nail & Tag Stamped "Oakland Co. Remonumentation P.S. #25854" in SW Root 15" Cherry S 53° E 46.08'
PK Nail & Tag Stamped "Oakland Co. Remonumentation P.S. #25854" in E Face P. Pole S 7° W 53.88'
PK Nail & Tag Stamped "Oakland Co. Remonumentation P.S. #25854" in S Root 36" Maple N 72° W 137.87'
PK Nail & Tag Stamped "Oakland Co. Remonumentation P.S. #25854" in E Face 30" Maple N 25° W 84.03'


The selected location is accepted by the Contractor and is generally accepted by professional surveyors as the best available evidence of the position of the original corner.

Signed by Randy J. Kolehouse
EARTH TECH

Date 12/22/95

Surveyor's Michigan License No. 25854

A	B	C	D	E	F	G	H	I	J	K	L	M
2	6	5	4	3	2	1						
3												
4	7	8	9	10	11	12						
5												
6	16	17	18	15	14	13						
7												
8	19	20	21	22	23	24						
9												
10	30	29	28	27	26	25						
11												
12	31	32	33	34	35	36						
13												

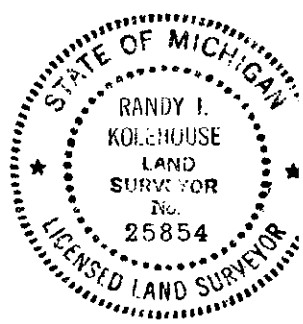

7.00
2.00
File