

COPY

LIBER 15550 pg 280

JUL 27 95 136685

\$ 7.00 MISCELLANEOUS RECORDING

\$ 2.00 REMONUMENTATION

LAND CORNER RECORDATION CERTIFICATE 27 JUL 95 3:35 P.M. RECEIPT# 1408  
Filing Requirement of Act 74, Mich. P.A. 1970 PAID RECORDED - OAKLAND COUNTY  
LYNN D. ALLEN, CLERK/REGISTER OF DEEDS

For corners in

Oakland (County)	Located in:	Addison Township	Corner Code #
1. Public Land Survey	T <u>5N</u>	R <u>11E</u>	<u>M-3</u>
	T _____	R _____	_____
	T _____	R _____	_____
	T _____	R _____	_____
2. Property Controlling in Section	S _____	T _____	R _____
	S _____	T _____	R _____
3. Miscellaneous Property in Sec.	S _____	T _____	R _____
	S _____	T _____	R _____

Compliance with  
ACT 345, P.A. 1990  
APPROVED ON: 6-19-95 TOWNS  
OAKLAND COUNTY REMONUMENTATION  
PEER GROUP COMMITTEE

Register of Deeds Stamp & File Number

- 4. Lot No. \_\_\_\_\_, Recorded Plat \_\_\_\_\_
- 5. Private Claims \_\_\_\_\_

I, Randy Kolehouse, in a field survey on May 8 19 95, do hereby certify that under requirements of P.A. 74 Michigan P.A. of 1970, the corner points mentioned in lines 1 and 2 above were in conformance with regulations and rules therefore as required in the current manual of survey instructions of the United States Department of the Interior, Bureau of Land Management or by a decree of a Court of Law and/or that the corner points mentioned in lines 3, 4 and 5 above were in conformance with the rules of the Michigan Board of Land Surveyors or by a Decree of a Court of Law; established, re-established, monumented, re-monumented, recovered, found as expressed below:

	A	B	C	D	E	F	G	H	I	J	K	L	M
2	6		5		4		3		2		1		
3													
4	7		6		5		4		3		2		1
5													
6	18		17		16		15		14		13		
7													
8	19		20		21		22		23		24		
9													
10	20		21		22		23		24		25		
11													
12	31		32		33		34		35		36		
13													

NOTE: Not more than 4 corners, all in the same town and range, may be recorded on this certificate.

A. Description of original monument and accessories and/or subsequent restoration:

M-3	Year	Name	Description	Monument
	1817	Wampler	G.L.O.	Set Post
	1974	Kobs	L.C.R.C. L. 2549 P. 11	Found 1/2" Iron Bar
	1978	Thompson	Survey for T5N R12E for Bruce Twp.	1/2" Iron by Large Pipe
	1991	Kostecke	Unrecorded Survey	Found 2" Iron Pipe
	1995	Kennedy	Survey in Sec. 1 w/Field Notes	Found 2" Pipe

B. Description of corner evidence found and/or method applied in restoring or reestablishing corner:

M-3 Found a 1/2" rerod and a 2" pipe which sticks 2 1/2' to 3' out of the ground in a pile of rocks on an East-West fence line. Rerod is 0.56' North of the 2" pipe. The rerod has been used as the corner A-3 T5N R12E Macomb Co. and the pipe has been used as M-3 T5N R11E Oakland Co. Measurements made from M-2 to the rebar agree with recorded distances made by Kostecke and Kennedy (calc). The pipe was probably set as a marker post not the Section Cor. Checks witnesses from L.C.R.C. L. 2549 P. 11 and above surveys.

Survey	Description
Kostecke Unrecorded Survey 1991	NW 8.7' PK & Nail 20" Birch
	SE 18.2' PK & Nail 28" Twin Tree
	WSW 46.7' PK & Nail 36" Twin Tree
Note: Cal. Cor. is N.60 and E/.60 of Said Iron	
Kennedy Unrecorded Survey 1995	N 65° E 22.10' PK & Washer NW Face 12" Maple
	Due South 5.50' PK & Washer West Face 12" Maple
	S 45° W 12.15' PK & Washer South Face 12" Cherry
	N 40° W 14.88' PK & Washer NE Face 24" Oak

Measures N from Rebar to E 1/4 Cor. = 2675.43' (G.L.O. = 2640') (Kostecke = 2675.46') (Kennedy = 2675.31' cal.)

C. Description of monument for corner and accessories established to perpetuate locating the position of the corner:


M-3 Replaced the 1/2" rebar with a 4" x 36" concrete monument with brass cap stamped "Oakland County Remonumentation P.S. #25854."

- PK Nail & Tag Stamped "Oakland Co. Remonumentation P.S. #25854" in NE Face 20" Poplar N 50° W 14.39'
- PK Nail & Tag Stamped "Oakland Co. Remonumentation P.S. #25854" in SE'ly Face 12" Maple S 44° W 12.55'
- PK Nail & Tag Stamped "Oakland Co. Remonumentation P.S. #25854" in SW Face 18" Twin Oak S 25° E 18.15'
- PK Nail & Tag Stamped "Oakland Co. Remonumentation P.S. #25854" in NW Face 12" Maple N 53° E 21.66'

The selected location is accepted by the Contractor and is generally accepted by professional surveyors as the best available evidence of the position of the original corner.

Signed by Randy J Kolehouse Date 7/14/95  
EARTH TECH

Surveyor's Michigan License No. 25854

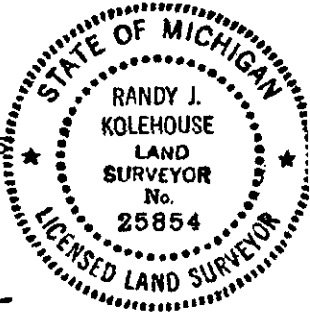

7.00  
2.00  
File