

STATE OF MICHIGAN
 COUNTY OF OCEANA
 RECEIVED FOR RECORD

3 DEC 1999 2:06:34 PM

JOSEPH E. MERTEN
 REGISTER OF DEEDS

100928

Register of Deeds Stamp & File Number

LAND CORNER RECORDATION CERTIFICATE
 Filing Requirement of Act 74, Mich. P.A. 1970

SECTION

For corners in

Oceana

(County)

Located In:

Corner Code #

1. Public Land Survey

T	13N	R	15W	F-11
T		R		
T		R		
T		R		
S		R		
S		R		
S		R		
S		R		

2. Property Controlling
 in Section

3. Miscellaneous
 Property in Sec.

4. Lot No. _____, Recorded Plat _____
 5. Private Claims _____

I, J. Randolph Hepworth in a field survey on August 12, 1999 do hereby state that under requirements of P.A. 74, Michigan P.A. of 1970, the corner points mentioned in lines 1 and 2 above were in conformance with regulations and rules therefore as required in the current manual of survey instructions of the United States Department of the Interior, Bureau of Land Management or by a decree of a Court of Law and /or that the corner points mentioned in lines 3, 4 and 5 above were in conformance with the rules of the Michigan Board of Land Surveyors or by a Decree of a Court of Law; established, re-established, monumented, recovered, found as expressed below:

NOTE: Not more than 2 corners, all in the same town and range, may be recorded on this certificate.

	A	B	C	D	E	F	G	H	I	J	K	L	M
1													
2	6		5		4		3		2		1		
3													
4	7		8		9		10		11		12		
5													
6	18		17		16		15		14		13		
7													
8	19		20		21		22		23		24		
9													
10	30		29		28		27		26		25		
11													
12	31		32		33		34		35		36		
13													

A. Description of original monument and accessories and/or subsequent restoration:

F-11 1/4 CORNER COMMON TO SECTIONS 28 & 33 T13N, R15W GREENWOOD TOWNSHIP

GLO J. Mullett 1838 SET POST fr which 18" W. Oak S67°E (10lks) 6.6' 12" W. Oak N60°W (34lks) 22.4'

LCRC # 100366, John Bueche #13027, 10/21/87, Fd 5/8" rerod On C/L 2-track N-S; C/L dirt rd E-W, N 5'

- 1) PK in W side 16" Oak N20°E 47.34'
- 2) PK in N side 16" Oak S80°E 88.00'
- 3) PK in W side Tw 10" Oak S10°E 83.12'
- 4) PK in SE side Tw 10" w. Cherry S70°W 38.87'
- 5) PK in S side Tw 10" Oak N80°E 101.04'

Oceana County Remonumentation
 Peer Group Reviewed & Approved

Date: 10-27-99
JRH

J. Randolph Hepworth
 Oceana County Surveyor

LCRC # 100369, Patrick R. Leemon, # 31595, 1/20/88, Fd 1" sq X several feet long Iron Rod Topped with a 3/4" Iron Rod

- 1) 14" B. Oak N17°E 47.84' (Obt)
- 6) 8" R. Pine N58°E 11.26' (Obt)
- 7) 6" W. Pine N41°W 69.40'
- 8) 4" Pine Post S47°W 44.21'
- 9) 1/2" X 18" Rebar (#31595) S58°E 68.54'

Recorded Survey Jkt # 593, Carl Englert, Jr., # 18987, 8/21/96, Fd Iron Bar

B. Description of corner evidence found and/or method applied in restoring or reestablishing corner.


I found a 3/4" sq Iron x quite long in the centerline intersection of E-W and N-S Roads. Upon excavation to 30" deep, I found several small stones and broken crockery and well-rusted metal pieces. All Bueche and Leemon witnesses are standing, except #6 and #8 are gone. No other historical documentation for this corner is known to me.

I accept the Iron as the best available evidence of the position of the original corner. No evidence is known to me that would lead me to believe the corner should be at another location.

C. Description of monument for corner and accessories established to perpetuate locating the position of the corner:

Set 4"x20" Harrison Cast Iron Monument, stamped "County Surveyor" and "26457" above the 3/4" Iron which was driven down.

Fd 60d Spk	W Face	26" Oak	19°Az	47.84'	tape
Set 60d Spk	NW Face	12" R. Pine	57° Az	111.29'	tape
60d Spk	SW Face	18" Oak	108°Az	77.92'	tape
60d Spk	NW Face	6" W Oak	237°Az	38.70'	tape
Fd 60d Spk	NE Face	6" W Pine	319°Az	69.35'	tape

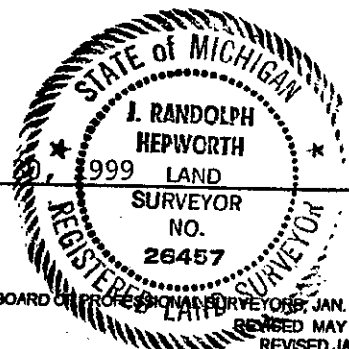

Signed by JRH
 Surveyor's Michigan License No. 26457

Date November 30, 1999