

FEB 2 9 1995

STATE OF MICHIGAN
COUNTY OF OCEANA
RECEIVED FOR RECORD

LAND CORNER RECORDATION CERTIFICATE

100672

Filing Requirement of Act 74, Mich. P.A. 1970 95 DEC 15 P 3:03

For corners in Oceana (County)	Located In:	Corner Code #
1. Public Land Survey	T <u>13N</u> R <u>17W</u>	<u>E-7</u>
	T _____ R _____	_____
	T _____ R _____	_____
	T _____ R _____	_____
2. Property Controlling in Section	S _____ T _____ R _____	_____
	S _____ T _____ R _____	_____
3. Miscellaneous Property in Section	S _____ T _____ R _____	_____
	S _____ T _____ R _____	_____

Joseph E. Martin
REGISTER OF DEEDS

Register of Deeds Stamp & File Number

4. Lot No. _____, Recorded Plat _____
5. Private Claims _____

	A	B	C	D	E	F	G	H	I	J	K	L	M
2	6		5		4		3		2		1		
3													
4	7		8		9		10		11		12		
5													
6	18		17		16		15		14		13		
7													
8	19		20		21		22		23		24		
9													
10	30		29		28		27		26		25		
11													
12	31		32		33		34		35		36		
13													

J. Randolph Hepworth Nov. 22, 1995

I, _____, in a field survey on _____, 19_____, do hereby certify that under requirements of P.A. 74, Michigan P.A. of 1970, the corner points mentioned in lines 1 and 2 above were in conformance with regulations and rules therefore as required in the current manual of survey instructions of the United States Department of the Interior, Bureau of Land Management or by a decree of a Court of Law and/or that the corner points mentioned in lines 3, 4 and 5 above were in conformance with the rules of the Michigan Board of Professional Surveyors or by a Decree of a Court of Law; established, re-established, monumented, re-monumented, recovered, found as expressed below:

NOTE: Not more than 4 corners, all in the same town and range, may be recorded on this certificate.

A. Description of original monument and accessories and/or subsequent restoration:

E-7 Corner Common to Sections 16, 17, 20, AND 21 T13N, R17W GRANT TOWNSHIP

GLO SET POST 16" Hemlock N18°W 7.3' 12" Hemlock N58°E 28.4'
Book A, Pg 72; S. Edson, 1880; Found Gov't Post & both Witness Trees Set a new Post
Book A, Pg 154; S. Edson, 1883; Corner not described or witnessed.
Book A, Pg 358; H. Grant, 1894; Corner not described or witnessed.
Book C, Pg 72; H. Salisbury, 1907; 2" x 5/8" iron 30" pine stump N73°30' E 48'

OCRC WITNESS: Undated, 2" x 5/8" iron
18" Oak N30°W 85.8' 24" Maple N23°E 60.0'

LCRC 100414, Hepworth, PS26457, 8-11-82; Found 1/2"x2" Iron Bar
36" Maple OBT NE 60.51 36" Oak OBT NW 86.65
6" Oak SW 42.05 St Name Sign SE 33.15 20' S of c/l Pymt to East

Oceana County Remonumentation
Peer Group Reviewed & Approved

Date: 12-7-95

JRH
J. Randolph Hepworth
Oceana County Surveyor

B. Description of corner evidence found and/or method applied in restoring or reestablishing corner

I found in the center of an asphalt road to the south, center of gravel road to the north, center of asphalt road to the east is 20 feet north, and center of trail to the west is 10 feet north, a 1/2" Iron 6" below the surface. On excavation and removal of the 1/2" Iron, I found it to be a riser above a 5/8"x2 3/8"-2" slightly trapezoidal shaped cast-iron bar at 14" deep.


This corner is substantially as described by Salisbury, 1907. Salisbury witness is gone but both OCRC witnesses are standing.

Further search of the area failed to yield any other evidence for a conflicting position for the corner. This represents the best available evidence for the position of the corner. The found 1/2" Iron above the 5/8"x2 3/8" bar is accepted as a careful and faithful perpetuation of the position of the original corner.

C. Description of monument for corner and accessories established to perpetuate locating the position of the corner.

Set "County Surveyor" Harrison 4"x20" Cast Iron Monument above found 5/8"x2 3/8" bar which was driven down.

60d spk SE Face	36" Maple	26°az	60.19	EDM
60d spk E Face	36" W Oak	338°az	86.57	EDM
60d spk SE Face	8" R Oak	303°az	46.74	EDM
60d spk SE Face	14" R Oak	235°az	42.41	EDM
60d spk SW Face	8" tw W Oak	143°az	52.49	EDM
60d spk NW Face	12" R Oak	52°az	60.62	EDM

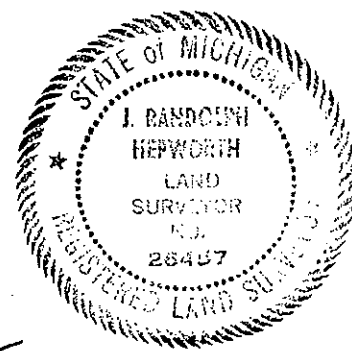

Signed by *J. Randolph Hepworth*
Surveyor's Michigan License No. 26457

Date 12-14-95