

**SURVEY & REMONUMENTATION**

FEB 02 1998

**SECTION**

**LAND CORNER RECORDATION CERTIFICATE**  
Filing Requirement of Act 74, Mich. P.A. 1970

100777

For corners in

<u>Oceana</u> (County)	Located In:	Corner Code #
1. Public Land Survey	T-13N R-17W	I-10
	T- R-	
	T- R-	
	T- R-	
2. Property Controlling in Section	S- T- R-	
	S- T- R-	
3. Miscellaneous Property in Sec.	S- T- R-	
	S- T- R-	

STATE OF MICHIGAN  
COUNTY OF OCEANA  
RECEIVED FOR RECORD  
13 Jan 1998 4:47:24 PM  
JOSEPH E. MERTEN  
REGISTER OF DEEDS  
**Register of Deeds Stamp & File Number**

4. Lot No. \_\_\_\_\_, Recorded Plat \_\_\_\_\_  
5. Private Claims \_\_\_\_\_

I, J. Randolph Hepworth, in a field survey on May 30, 1997 do hereby state that under requirements of P.A. 74, Michigan P.A. of 1970, the corner points mentioned in lines 1 and 2 above were in conformance with regulations and rules therefore as required in the current manual of survey instructions of the United States Department of the Interior, Bureau of Land Management or by a decree of a Court of Law and /or that the corner points mentioned in lines 3, 4 and 5 above were in conformance with the rules of the Michigan Board of Land Surveyors or by a Decree of a Court of Law; established, re-established, monumented, recovered, found as expressed below:

NOTE: Not more than 2 corners, all in the same town and range, may be recorded on this certificate.

1	A	B	C	D	E	F	G	H	I	J	K	L	M
2	6		5		4		3		2		1		
3													
4	7		8		9		10		11		12		
5													
6	18		17		16		15		14		13		
7													
8	19		20		21		22		23		24		
9													
10	30		29		28		27		26		25		
11													
12	31		32		33		34		35		36		
13													

A. Description of original monument and accessories and/or subsequent restoration:

**I-10 1/4 CORNER COMMON TO SECTIONS 26 & 27 T13N, R17W GRANT TOWNSHIP**  
GLO SET POST 6" Hemlock S79°W 9.2' 6" Hemlock N54°E 10.6'  
LCRC # 100225, C. Lewandoski # 7867, 7-3-78, Fd Pinched Pipe  
+/- C/L Pipe Line W 53' 3" Oak N75°W 12.0' 6" Maple S07°W 25.23' 3" Maple S88°E 27.5'  
8" Pine N20°E 39.0' C/L Pipe Marker N38°W 88.4'  
Unrecorded Survey R. Hepworth # 26457 8-11-95 Fd 1" Pinched Pipe  
60d Spike in W Face 10" Maple 188°AZ 25.23'  
60d Spike in NE Face 8" Oak 296°AZ 12.00'  
60d Spike in E Face 6" W Pine 18°AZ 39.06'  
60d Spike in N Face 6" Maple 90°AZ 27.48'

B. Description of corner evidence found and/or method applied in restoring or reestablishing corner.  
I found a 3/4" pinched Pipe projecting 1" above ground. No occupation is visible in any direction. All Lewandoski witnesses are standing and measure good.

The found 3/4" Pipe is accepted as a careful and faithful perpetuation of the position of the original corner. No evidence is known to me that would lead me to believe that the corner should be at another location. I placed a 4"x20" Harrison Cast Iron Monument stamped "County Surveyor" and "26457" above the pipe which was driven down.


C. Description of monument for corner and accessories established to perpetuate locating the position of the corner.

**I-10 1/4 CORNER COMMON TO SECTIONS 26 & 27 T13N, R17W GRANT TOWNSHIP**  
4"x20" Harrison Cast Iron Monument stamped "County Surveyor" and "26457"  
centerline N-S Pipe Line W 53'  
60d spk W Face 10" Maple 188°az 25.23 tape  
60d spk NE Face 8" Oak 296°az 12.00 tape  
60d spk E Face 6" W Pine 18°az 39.06 tape  
60d spk N Face 6" Maple 90°az 27.48 tape

Oceana County Remonumentation Peer Group Reviewed & Approved

Date: 9-18-97

J. Randolph Hepworth  
Oceana County Surveyor

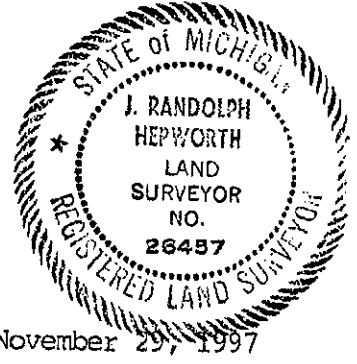

Signed by J. Randolph Hepworth  
Surveyor's Michigan License No. 26457

Date November 29, 1997