

SURVEY & REMONUMENTATION

FEB 02 1998

100784

SECTION LAND CORNER RECORDATION CERTIFICATE

Filing Requirement of Act 74, Mich. P.A. 1970

For corners in

Oceana (County)

Located in:

Corner Code #

- 1. Public Land Survey T 13N R 18W G-9
- T _____ R _____
- T _____ R _____
- T _____ R _____
- 2. Property Controlling S _____ T _____ R _____
- In Section S _____ T _____ R _____
- 3. Miscellaneous S _____ T _____ R _____
- Property in Section S _____ T _____ R _____


STATE OF MICHIGAN
COUNTY OF OCEANA
RECEIVED FOR RECORD

13 Jan 1998 4:49:04 PM

JOSEPH E. MERTEN
REGISTER OF DEEDS

Register of Deeds Stamp & File Number

- 4. Lot No. _____, Recorded Plat _____
- 5. Private Claims _____

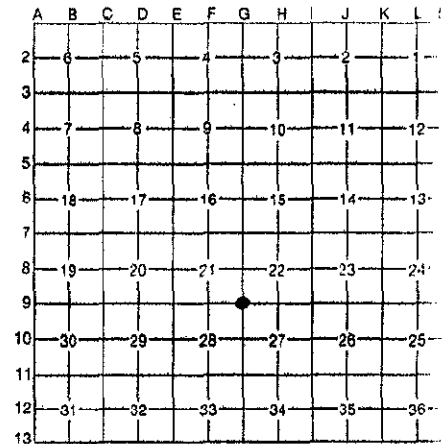

J. Randolph Hepworth, in a field survey on May 5, 1997

do hereby certify that under requirements of P.A. 74, Michigan P.A. of 1970, the corner points mentioned in lines 1 and 2 above were in conformance with regulations and rules therefore as required in the current manual of survey instructions of the United States Department of the Interior, Bureau of Land Management or by a decree of a Court of Law and/or that the corner points mentioned in lines 3, 4 and 5 above were in conformance with the rules of the Michigan Board of Professional Surveyors or by a Decree of a Court of Law; established, re-established, monumented, re-monumented, recovered, found as expressed below:

NOTE: Not more than 4 corners, all in the same town and range, may be recorded on this certificate.

A. Description of original monument and accessories and/or subsequent restoration:

G-9 Corner Common to Sections 21, 22, 27, and 28 T13N, R18W CLAYBANKS TOWNSHIP

GLO SET POST 18" Birch S18°E 9.9' 12" Maple S52°W 12.5'

Book A, Pg 128; S. Edson, 1882; "Witness stump found and stake drove"
4" Maple N82°W 23.8' 5" Birch S76 1/2°E 36.3'

Book A, Pg 138; S. Edson, 1882; Corner not described or witnessed.

Book A, Pg 148; S. Edson, 1883; "Both witness stumps plain to be seen from which we established this corner"
4" Maple N82°W 23.8' 5" Birch S76 1/2°E 36.3'

1 CRD 100313, Hackbardt, PS25844, 2-4-84; Found 1 1/2" L Iron 20' N of south edge of cedar swamp also found 1/8 post to west which fell on line and 1/2 way between G-9 and F-9

12" Maple N20°E 27.10 15" Maple N70°W 36.7 12" Maple S20°W 18.0
22" Maple S10°E 16.8

Act 132 survey, Hackbardt, PS25844, 2-4-84; same as above

B. Description of corner evidence found and/or method applied in restoring or reestablishing corner

I found a 1 1/2" "L" Iron projecting 6" in a very wet cedar Swamp. Westerly edge of swamp is 23± west; the southerly edge of swamp is 35± south. Old Fence fragments were found to the north and west of this corner. Edson, 1883 witnesses are gone.


Further search of the area failed to yield any other evidence for a conflicting position for the corner. This represents the best available evidence for the position of the corner. The Found 1 1/2" Iron is accepted as a careful and faithful perpetuation of the position of the original corner.

C. Description of monument for corner and accessories established to perpetuate locating the position of the corner.

G-9 Corner Common to Sections 21, 22, 27, and 28 T13N, R18W CLAYBANKS TOWNSHIP

Set 5/8"x48" Iron Rod with cast aluminum cap stamped "Oceana County Remonumentation" and "26457" inside the "ell" of the 1 1/2" Angle Iron which was left in place.

60d spk	N Face	16" Maple	71°az	27.27	tape
60d spk	W Face	10" Maple	00°az	32.46	tape
20d spk	N Face	24" Maple	210°az	17.82	tape
20d spk	S Face	6" Hemlock	235°az	28.47	tape
20d spk	S Face	16" Maple	269°az	18.49	tape
20d spk	SE Face	16" Hemlock	297°az	42.67	tape

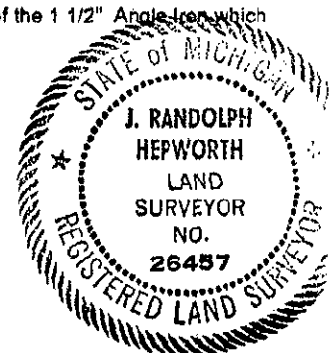

Signed by J. Randolph Hepworth
Surveyor's Michigan License No. 26457

Date 10-2-97