

**LAND CORNER RECORDATION CERTIFICATE**  
**Filing Requirement of Act 74, Mich. P.A. 1970**

**100965**

STATE OF MICHIGAN  
 COUNTY OF OCEANA  
 RECEIVED FOR RECORD

3 DEC 1999 2:17:52 PM

JOSEPH E. MERTEN  
 REGISTER OF DEEDS

For corners in

Oceana

(County)

Located in:

Corner Code #

1. Public Land Survey

T	<u>13N</u>	<u>R18W</u>	<u>I-11</u>
T	___	___	___
T	___	___	___
T	___	___	___
S	___	___	___
S	___	___	___
S	___	___	___
S	___	___	___

2. Property Controlling  
 in Section

3. Miscellaneous  
 Property in Sec.

4. Lot No. \_\_\_\_\_, Recorded Plat \_\_\_\_\_  
 5. Private Claims \_\_\_\_\_

Register of Deeds Stamp & File Number

I, J. Randolph Hepworth in a field survey on June 9, 19 99 do hereby state that under requirements of P.A. 74, Michigan P.A. of 1970, the corner points mentioned in lines 1 and 2 above were in conformance with regulations and rules therefore as required in the current manual of survey instructions of the United States Department of the Interior, Bureau of Land Management or by a decree of a Court of Law and /or that the corner points mentioned in lines 3, 4 and 5 above were in conformance with the rules of the Michigan Board of Land Surveyors or by a Decree of a Court of Law; established, re-established, monumented, recovered, found as expressed below:

NOTE: Not more than 2 corners, all in the same town and range, may be recorded on this certificate.

	A	B	C	D	E	F	G	H	I	J	K	L	M
1													
2	6		5		4		3		2		1		
3													
4	7		8		9		10		11		12		
5													
6	18		17		16		15		14		13		
7													
8	19		20		21		22		23		24		
9													
10	30		29		28		27		26		25		
11													
12	31		32		33		34		35		36		
13													

A. Description of original monument and accessories and/or subsequent restoration:

**I-11 CORNER COMMON TO SECTIONS 26, 27, 34 and 35 T13N, R18W CLAYBANKS TOWNSHIP**

GLO J. Mullett 1838 SET POST 18" Birch S22°W (18 lks) 11.9' 18" Birch S60°E (32 lks) 21.1'

Book A, Pg 146; S. Edson, 1882; "A rough triangular stone about 20" long, and 15" wide. Said stone has a seam running about 2/3 across the top."

Book A, Pg 148; S. Edson, 1882; "See No. one (1) one page 146 (Above)."

Book A, Pg 158; S. Edson, 1883; Corner not described or witnessed.

Unrecorded Survey, J. R. Hepworth #26457, 8/86 & 10/95, Fd Bolt

B. Description of corner evidence found and/or method applied in restoring or reestablishing corner.

I found a 5/8"x0.9" Bolt with nut on top at 0.2' below the surface in centerline intersection of roads E-W and N-S. Upon excavation and removal, I found a 1/2" rebar at 12" deep at the former road bed surface and found it to be 0.9' long. Upon probing, I could not locate any stone and no other iron object was detected.

I accept this iron as the best available evidence of the position of the original corner. No evidence is known to me that would lead me to believe the corner should be at another location.

C. Description of monument for corner and accessories established to perpetuate locating the position of the corner:


Set 4"x20" Harrison Cast Iron Monument, stamped "County Surveyor" and "26457". The irons were placed in the hole.

60d spk	SW Face	Power Pole/transf	330°az	86.10'	EDM
60d spk	W Face	Power Pole	20°az	78.21'	EDM
60d spk	E Face	Power Pole	172°az	196.56'	EDM
chiseled 'v' in east end of CMP culvert			146°az	35.43'	EDM
chiseled 'v' in west end of CMP culvert			223°az	39.06'	EDM

Oceana County Remonumentation  
 Peer Group Reviewed & Approved

Date: 11-11-99

JRH  
 J. Randolph Hepworth  
 Oceana County Surveyor

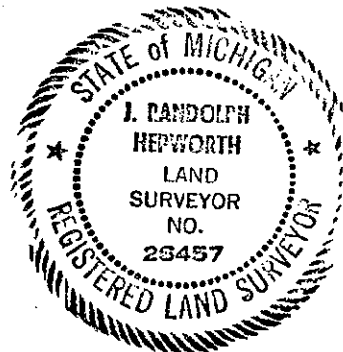

Signed by J. Randolph Hepworth

Date November 30, 1999

Surveyor's Michigan License No. 26457