

FEB 22 1995

STATE OF MICHIGAN
COUNTY OF OCEANA
RECEIVED FOR RECORD
100656
95 DEC 15 P 3:01

LAND CORNER RECORDATION CERTIFICATE
Filing Requirement of Act 74, Mich. P.A. 1970


For corners in Oceana Located In: _____ Corner Code # _____
(County)

- | | | | | | |
|--------------------------------------|---|------------|---|------------|------------|
| 1. Public Land Survey | T | <u>14N</u> | R | <u>15W</u> | <u>E-4</u> |
| | T | _____ | R | _____ | _____ |
| | T | _____ | R | _____ | _____ |
| | T | _____ | R | _____ | _____ |
| 2. Property Controlling in Section | S | _____ | T | _____ | R |
| | S | _____ | T | _____ | R |
| 3. Miscellaneous Property in Section | S | _____ | T | _____ | R |
| | S | _____ | T | _____ | R |

Joseph E. Melton
REGISTER OF DEEDS

Register of Deeds Stamp & File Number

4. Lot No. _____, Recorded Plat _____
5. Private Claims _____

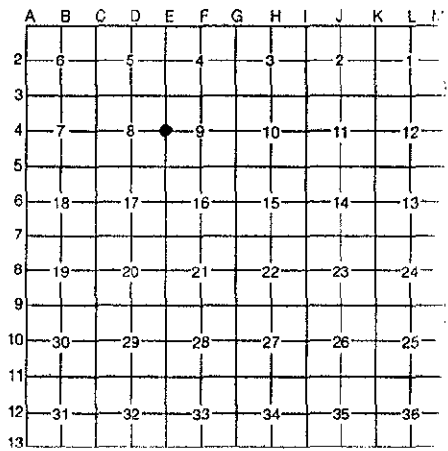

J. Randolph Hepworth Nov. 20, 1995

I, _____, in a field survey on _____, 19_____, do hereby certify that under requirements of P.A. 74, Michigan P.A. of 1970, the corner points mentioned in lines 1 and 2 above were in conformance with regulations and rules therefore as required in the current manual of survey instructions of the United States Department of the Interior, Bureau of Land Management or by a decree of a Court of Law and/or that the corner points mentioned in lines 3, 4 and 5 above were in conformance with the rules of the Michigan Board of Professional Surveyors or by a Decree of a Court of Law; established, re-established, monumented, re-monumented, recovered, found as expressed below:

NOTE: Not more than 4 corners, all in the same town and range, may be recorded on this certificate.

A. Description of original monument and accessories and/or subsequent restoration:

E-4 1/4 CORNER COMMON TO SECTIONS 8 AND 9 T14N, R15W NEWFIELD TOWNSHIP

GLO SET POST 12"Beech S85°E 21.1' 8"Beech N21°E 5.9'
 GLO Stream crossing - Course West South 1158'
 Book A, pg 578, H. C. Hawley, 1883, "Hole 3' deep, 3 1/4" dia. filled with charcoal, broken bricks, crockery, etc.
 24" Maple S49°E 66.7' Gov't Witness Stump"
 Book A, Pg 352; H. Grant, 1894; "Hemlock stake 32" Pine stump N70°W 83.82'
 12" Beech S78 3/4°W 70' "

OCRC WITNESS BOOK Undated Axle & wood stake & crockery
 10" Oak N64°W 56.1' 10" Oak N30°W 69.0' 22" Oak S41°E 74.8' 4" Oak N36°E 34.9'

LCRC # 100441 Hepworth #26457 7-30-90 Found Axle & Crockery
 P. Pole 123°az 60.22' 20" W. Oak 44° 34.78' 24" W. Oak 300° 56.28'
 8" W. Oak 233° 60.35'

Oceana County Reestablishment
 Peer Group Reviewed & Approved
 Date: 12-7-95
J. Randolph Hepworth
 Oceana County Surveyor

B. Description of corner evidence found and/or method applied in restoring or reestablishing corner

I found in the center of a north-south gravel Road and 8" below the surface an Auto Axle with broken bits of Crockery, old broken brick & bits of charcoal. While I did find the material described by Hawley, 1883, I did not find real evidence of a 3" dia hole filled with this material as others I have found. Otherwise, this corner is substantially as described by Hawley and by OCRC Witnesses.

No occupation is visible to the east. An old plow row with old wire runs to the west 19' North of this position. GLO Witnesses- Gone, although measurement to the White River measures excellent. Hawley & Grant Witnesses- Gone. 3 OCRC witnesses are standing and measure well.

Further search of the area failed to yield any other evidence for a conflicting position for the corner. This represents the best available evidence for the position of the corner. The found Axle Shaft and surrounding material is accepted as a careful and faithful perpetuation of the position of the original corner.

C. Description of monument for corner and accessories established to perpetuate locating the position of the corner.

E-4 1/4 CORNER COMMON TO SECTIONS 8 AND 9 T14N, R15W NEWFIELD TOWNSHIP

Set "County Surveyor" Harrison 4"X20" Cast Iron Monument above found Axle Shaft which was driven down.

16d spk/washer	SW Face	Power Pole	111°az	60.22	EDM
60d spk	NW Face	24" W Oak	37°az	34.81	EDM
60d spk	E Face	12", 18" W Oak	330°az	67.90	EDM
60d spk	NW Face	8" W Oak	233°az	60.26	EDM
60d spk	NE Face	24" W Oak	297°az	56.18	EDM
center of culvert	White River		South	1156'	EDM

Signed by *J. Randolph Hepworth* Date 12-14-95
Surveyor's Michigan License No. 26457

