

MAY 16 1997

LAND CORNER RECORDATION CERTIFICATE

100684

Filing Requirement of Act 74, Mich. P.A. 1970

'96 DEC 19 AM 11

For corners in
Oceana
(County)

Located In:

Corner Code #

- 1. Public Land Survey T 14N R 15W G-5
T _____ R _____
T _____ R _____
T _____ R _____
- 2. Property Controlling S _____ T _____ R _____
in Section S _____ T _____ R _____
- 3. Miscellaneous S _____ T _____ R _____
Property in Section S _____ T _____ R _____
- 4. Lot No. _____, Recorded Plat _____
- 5. Private Claims _____

J. Randolph Hepworth
REGISTER OF DEEDS

Register of Deeds Stamp & File Number

I, J. Randolph Hepworth, in a field survey on May 29, 19 96, do hereby certify that under requirements of P.A. 74, Michigan P.A. of 1970, the corner points mentioned in lines 1 and 2 above were in conformance with regulations and rules therefore as required in the current manual of survey instructions of the United States Department of the Interior, Bureau of Land Management or by a decree of a Court of Law and/or that the corner points mentioned in lines 3, 4 and 5 above were in conformance with the rules of the Michigan Board of Professional Surveyors or by a Decree of a Court of Law; established, re-established, monumented, re-monumented, recovered, found as expressed below:

	A	B	C	D	E	F	G	H	I	J	K	L
2	6		5		4		3		2			
3												
4	7		8		9		10		11		12	
5												
6	18		17		16		15		14		13	
7												
8	19		20		21		22		23		24	
9												
10	30		29		28		27		26		25	
11												
12	31		32		33		34		35		36	
13												

NOTE: Not more than 4 corners, all in the same town and range, may be recorded on this certificate.

A. Description of original monument and accessories and/or subsequent restoration:

G-5 Corner Common to Sections 9, 10, 15, & 16 T14N, R15W Newfield Township

GLO SET POST 18"Hemlock N71°E 11.2' 15"Sugar N69°W 21.1'
 Book A, Pg 577; H.C.Hawley, 1883, Hole of 3' deep by 3 1/4" in dia. filled with charcoal, broken brick, crockery, etc. No witnesses
 Book C, Pg 74; H. Salisbury, 1907; "Half round iron surrounded by brick fr. wh. 8"Elm N68°15'W 64.4' 12"Elm N72°15'E 79.1"
 Book C, Pg 152; E. Hyde, 1910; "Iron Corner"
 OCRC WITNESS BOOK Undated 3/4" round bolt 10"Apple N64°E 93.52' 6"Apple S10°E 38.84' 6"Apple N55°W 87.63'

LCRC# 100190 Ochs PS 22439 12-23-75 Fnd 3/4" round Bolt
 10" apple N64°E 93.52' 6" Apple S10°E 38.84' 6" Apple N55°W 87.63'

P.A. 132 Survey Jacket # 174 Norman L. Ochs PS 22439 12-4-75 Fnd 3/4" round Bolt
 10" apple N64°E 93.52' 6" Apple S10°E 38.84'

P.A. 132 Survey Jacket # 225 Clinton Cole PS 17615 1-14-77
 10" apple N54°E 93.47' 6" Apple S2°E 38.86' 6" Apple N61°W 87.67'

Unrecorded Survey Robert Wetherell PS 24624 6-12-79
 10" apple N64°E 93.47' 6" Apple S2°E 38.86' 6" Apple N61°W 87.67'

R. Hepworth PS 26457 Unrecorded Survey 3-28-86 Fnd 1" Bolt
 6"Apple S10°E 38.84' 1/2" IR N 33.0' 1/2" IR S 33.0'

Oceana County Remonumentation
Peer Group Reviewed & Approved

Date: 11-7-96

J. Randolph Hepworth
Oceana County Surveyor


B. Description of corner evidence found and/or method applied in restoring or reestablishing corner.

I found at 4" deep a round iron bar with a 2" half-round head with a 12" long 1" dia. shaft in the centerline of a E-W gravel road and on a newer (est. 20 years old) woven wire fence to the north. Upon excavation and removal of the iron bar, I found it to be beside another iron 1"x2"x12" long piece of cast iron (appears to be a sleigh shoe) and also was found to be surrounded by crockery and charcoal. The corner evidence found is substantially as described by Hawley & Salisbury, 1907 and by OCRC.

This iron and charcoal and crockery was accepted as the best evidence of the corner and was accepted as being a careful and faithful perpetuation of the original corner. No evidence is known to me that would lead me to believe that the corner should be in another location. The irons were driven down and I placed a 4"x20" Harrison Cast Iron Monument, stamped "County Surveyor" & "26457" above them at the found position.

C. Description of monument for corner and accessories established to perpetuate locating the position of the corner.

G-5 Corner Common to Sections 9, 10, 15 & 16 T14N, R15W Newfield Township
 4"x20" Harrison Cast Iron Monument, stamped "County Surveyor" & "26457"
 60d spk NE Face 16" Apple 131°az 59.24 EDM
 60d spk W Face clp 8" Apple 173°az 38.79 EDM
 60d spk NW Face 10" Apple 221°az 51.45 EDM
 40d spk E Face Power Pole 0°az 34.95 EDM
 Found 1/2" Iron, LS22439 south 32.93 EDM
 Found 1/2" Iron, LS17615 north 32.98 EDM

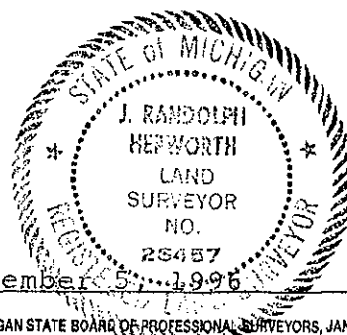

Signed by *J. Randolph Hepworth*

Date December 5, 1996

Surveyor's Michigan License No. 26457