

MAY 1 6 1997

STATE OF MICHIGAN
COUNTY OF OCEANA

LAND CORNER RECORDATION CERTIFICATE
Filing Requirement of Act 74, Mich. P.A. 1970

100690
96 DEC 19 AM 11:12

For corners in Oceana Located in: _____ Corner Code # _____
(County)

1. Public Land Survey T 14N R 15W _____ I-3
T _____ R _____
T _____ R _____
T _____ R _____

2. Property Controlling S _____ T _____ R _____
in Section S _____ T _____ R _____

3. Miscellaneous S _____ T _____ R _____
Property in Section S _____ T _____ R _____

J. Randolph Hepworth
REGISTER OF DEEDS

Register of Deeds Stamp & File Number

4. Lot No. _____, Recorded Plat _____
5. Private Claims _____

	A	B	C	D	E	F	G	H	I	J	K	L	M
2	6		5		4		3		2		1		
3													
4	7		8		9		10		11		12		
5													
6	18		17		16		15		14		13		
7													
8	19		20		21		22		23		24		
9													
10	30		29		28		27		26		25		
11													
12	31		32		33		34		35		36		
13													

I, J. Randolph Hepworth, in a field survey on July 12, 19 96, do hereby certify that under requirements of P.A. 74, Michigan P.A. of 1970, the corner points mentioned in lines 1 and 2 above were in conformance with regulations and rules therefore as required in the current manual of survey instructions of the United States Department of the Interior, Bureau of Land Management or by a decree of a Court of Law and/or that the corner points mentioned in lines 3, 4 and 5 above were in conformance with the rules of the Michigan Board of Professional Surveyors or by a Decree of a Court of Law; established, re-established, monumented, re-monumented, recovered, found as expressed below:

NOTE: Not more than 4 corners, all in the same town and range, may be recorded on this certificate.

A. Description of original monument and accessories and/or subsequent restoration:

I-3 CORNER COMMON TO SECTIONS 2, 3, 10 & 11 T14N, R15W, NEWFIELD TWP

GLO SET POST 18" Hemlock S20°W 19.8' 12" Hemlock N44°W 5.9'

BOOK A, PG 576; Henry C. Hawley, 1885; Corner in N. Branch of White River Old Corner NO WITNESS
BOOK C, PG 44; unsigned, circa 1903; Set corner on S. Bank of N. Branch White River NO WITNESSES.
BOOK C, PG 56; HC SALISBURY, 1908; Iron & stake under center of Bridge

OCRC, undated; Axle & Crockery 10" Elm S30°W 87.8 6" tw Elm S23°E 73.6 12" Oak S40°E 70.0

B. Description of corner evidence found and/or method applied in restoring or reestablishing corner

I set this corner in 1992. No OCRC witnesses are standing. Corner falls in area of about 25 feet of Road fill above original ground level. I found a 1 1/4" Iron at the 1/16 corner, 1/4 mile north of this corner. Using the 3/8" Iron found at the 1/4 corner between Section 2 and 3, I measured 1324.78 feet to the 1/16 corner; Salisbury, 1908, measures 1325.9 feet. Salisbury, 1905, shows a 05' deflection at the 1/4 corner; I measure a 06'40" deflection. I projected this 1324.78 feet south from the 1/16 corner and set a 1/2"x2" Iron in the center of the north-south asphalt road. Corner falls approximately in the center of the River as presently located by the very large culvert. Corner position is further confirmed by measurement west to the 1/4 corner between Section 3 and 10: Hepworth, 1992, 2568.18 feet and Salisbury, 1908, is 2572.7 feet.

No evidence is known to me that would lead me to believe that the corner should be at any other location.


The 1/2" Iron IS ACCEPTED AS A CAREFUL AND FAITHFUL ESTABLISHMENT OF THE POSITION OF THE ORIGINAL CORNER.

C. Description of monument for corner and accessories established to perpetuate locating the position of the corner.

I-3 CORNER COMMON TO SECTIONS 2, 3, 10 & 11 T14N, R15W, NEWFIELD TWP

Set 5/8"x36" Iron with cast aluminum cap stamped "Oceana County Remonumentation" and "26457" in place of found 1/2" IRON

PK Nail NE Cor	Guard Rail Post	272°az	15.38	
PK Nail NE Cor	Guard Rail Post	302°az	31.26	
PK Nail NW Cor	Guard Rail Post	81°az	17.72	
PK Nail SW Cor	Guard Rail Post	147°az	29.17	
60d spk NE Face	14" W Oak	135°az	101.76	EDM.
60d spk SW Face	12" R Oak	124°az	95.68	EDM
60d spk S Face	30" Maple	117°az	94.62	EDM
60d spk SE Face	6" Maple	17°az	93.05	EDM

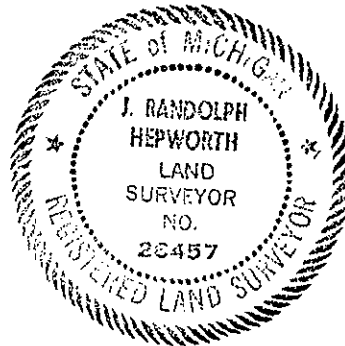

Oceana County Remonumentation
Peer Group Reviewed & Approved

Date: 8-18-94

JRH
J. Randolph Hepworth
Oceana County Surveyor

Signed by _____ Date December 5, 1996

Surveyor's Michigan License No. 26457