

MAY 18 1997

STATE OF MICHIGAN
COUNTY OF OCEANA
REGISTERED PROFESSIONAL SURVEYOR

100694

LAND CORNER RECORDATION CERTIFICATE

Filing Requirement of Act 74, Mich. P.A. 1970'96 DEC 19 AM 11:12

For corners in <u>Oceana</u> (County)	Located In:	Corner Code #
1. Public Land Survey	T <u>14N</u> R <u>15W</u>	<u>T-8</u>
	T _____ R _____	_____
	T _____ R _____	_____
	T _____ R _____	_____
2. Property Controlling in Section	S _____ T _____ R _____	_____
	S _____ T _____ R _____	_____
3. Miscellaneous Property in Section	S _____ T _____ R _____	_____
	S _____ T _____ R _____	_____

Joseph E. Martine
REGISTER OF DEEDS

Register of Deeds Stamp & File Number

4. Lot No. _____, Recorded Plat _____
5. Private Claims _____

A	B	C	D	E	F	G	H	I	J	K	L
2	6	5	4	3	2						
3											
4	7	8	9	10	11	12					
5											
6	18	17	16	15	14	13					
7											
8	19	20	21	22	23	24					
9											
10	30	29	28	27	26	25					
11											
12	31	32	33	34	35	36					
13											

I, J. Randolph Hepworth, in a field survey on July 12, 1996, do hereby certify that under requirements of P.A. 74, Michigan P.A. of 1970, the corner points mentioned in lines 1 and 2 above were in conformance with regulations and rules therefore as required in the current manual of survey instructions of the United States Department of the Interior, Bureau of Land Management or by a decree of a Court of Law and/or that the corner points mentioned in lines 3, 4 and 5 above were in conformance with the rules of the Michigan Board of Professional Surveyors or by a Decree of a Court of Law; established, re-established, monumented, re-monumented, recovered, found as expressed below:

NOTE: Not more than 4 corners, all in the same town and range, may be recorded on this certificate.

A. Description of original monument and accessories and/or subsequent restoration:

I-8 1/4 CORNER COMMON TO SECTIONS 22 & 23 T14N, R15W, NEWFIELD TWP

GLO SET POST on N side of Swamp 10" Maple N12°E 8.6' 8" Hemlock N18°W 9.9'
BOOK A, PG 576; Henry C. Hawley, 1885; Hole 3" deep & 3 1/4" dia filled w/ brick, charcoal, glass & crockery No
witness recited
BOOK C, PG 178, HC Salisbury, undated; Gas Pipe No Witness

OCRC, undated; 2" Flat Iron Cor fnc Post W 29.3 Cor Fnc Post S45°E 44.7

VALLIER, PS 28428; Letter dated July 22, 1994; Set 1/2" Iron on the extension of the line between I-9 corner and the south 1/16 corner (a found 1" L Iron per County Record; set a 1/2" Iron over it) at double the measured distance between said corners (2632.56 feet). He checked the distance from I-8 to J-8 (C 1/4 corner of Section 23 (a found 1" Pipe per County Record). Record distance was 2676.96 feet; measured distance was 2675.37 feet.

B. Description of corner evidence found and/or method applied in restoring or reestablishing corner

I found a 1/2" Iron & cap- RLS 28428- Stephen Vallier, Westshore Engineering. In the center of a North-south asphalt road; center of Gravel road to east; and 3' North of old fence line to west. Road bed grade is about 10 feet above original ground grade at this road intersection. Original ground is the north edge of swamp at this corner. No evidence is visible of any digging in the existing pavement. No OCRC witnesses are standing.

No evidence is known to me that would indicate that this corner should be in another location.

The found 1/2" Iron by Vallier IS ACCEPTED AS A CAREFUL AND FAITHFUL ESTABLISHMENT OF THE POSITION OF THE ORIGINAL CORNER.

C. Description of monument for corner and accessories established to perpetuate locating the position of the corner.


I-8 1/4 CORNER COMMON TO SECTIONS 22 & 23 T14N, R15W, NEWFIELD TWP

Set 5/8"x32" Iron with cast aluminum cap stamped "Oceana County Remonumentation" and "26457" in place of the found 1/2" Iron
50d spk N Face 18" R Oak 100°az 169.33 EDM
PK Nail N Face Tel. Pole 82°az 183.44 EDM
16d spk NW Face Power Pole 216°az 55.85 EDM
60d spk S Face clp 6",8" Box Elder 258°az 67.20 EDM
corner of old wood fence post 267°az 33.5
60d spk W Face 10" R Oak 9°az 197.36 EDM

Oceana County Remonumentation
Peer Group Reviewed & Approved

Date: 8-18-94

J. Randolph Hepworth
J. Randolph Hepworth
Oceana County Surveyor

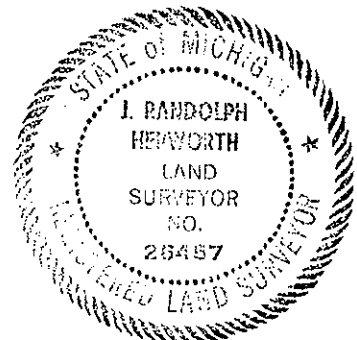

Signed by J. Randolph Hepworth
Surveyor's Michigan License No. 26457

Date December 5, 1996