

MAY 1 8 1997

STATE OF MICHIGAN  
COUNTY OF OCEANA  
RECEIVED FOR RECORDING

100695

LAND CORNER RECORDATION CERTIFICATE

Filing Requirement of Act 74, Mich. P.A. 1970

For corners in

Oceana

(County)

Located In:

Corner Code #

1. Public Land Survey	T <u>14N</u>	R <u>15W</u>	<u>I-9</u>
	T _____	R _____	_____
	T _____	R _____	_____
	T _____	R _____	_____
2. Property Controlling in Section	S _____	T _____	R _____
	S _____	T _____	R _____
3. Miscellaneous Property in Section	S _____	T _____	R _____
	S _____	T _____	R _____

*J. Randolph Hepworth*  
REGISTER OF DEEDS

Register of Deeds Stamp & File Number

4. Lot No. \_\_\_\_\_, Recorded Plat \_\_\_\_\_  
5. Private Claims \_\_\_\_\_

A	B	C	D	E	F	G	H	I	J	K	L
2	6	5	4	3	2						
3											
4	7	8	9	10	11	12					
5											
6	18	17	16	15	14	13					
7											
8	19	20	21	22	23	24					
9											
10	30	29	28	27	26	25					
11											
12	31	32	33	34	35	36					
13											

I, J. Randolph Hepworth, in a field survey on July 12, 1996, do hereby certify that under requirements of P.A. 74, Michigan P.A. of 1970, the corner points mentioned in lines 1 and 2 above were in conformance with regulations and rules therefore as required in the current manual of survey instructions of the United States Department of the Interior, Bureau of Land Management or by a decree of a Court of Law and/or that the corner points mentioned in lines 3, 4 and 5 above were in conformance with the rules of the Michigan Board of Professional Surveyors or by a Decree of a Court of Law; established, re-established, monumented, re-monumented, recovered, found as expressed below:

NOTE: Not more than 4 corners, all in the same town and range, may be recorded on this certificate.

A. Description of original monument and accessories and/or subsequent restoration:

I-9 CORNER COMMON TO SECTIONS 22, 23, 26 & 27 T14N, R15W, NEWFIELD TWP

GLO SET POST 10" Beech S25°E 19.8' 8" Maple S78°W 21.1'

BOOK A, PG 576; Henry C. Hawley, 1885; Hole 3' deep & 3 1/4" dia filled w/ brick, charcoal, glass & crockery in Highway No witness recited

BOOK C, PG 160, HC Salisbury, undated; Stone No Witness

Book C, PG 174 HC Salisbury, 1917; 2" Gas Pipe on Stone 12" Apple S45°W 52.5'

BOOK C, PG 178, HC Salisbury, undated; Gas Pipe on Stone

OCRC, undated; 2" Gas Pipe 1 1/4" sq Iron 15" Apple S20°W 77.5 Tel Pole N65°W 50.0

B. Description of corner evidence found and/or method appned in restoring or reestablishing corner

I found a 1/2" Iron near surface of north-south asphalt road on old fence line to east and 6' north of center of gravel road to west. On removal of 1/2" Iron, I found it to be above a 1" sq. Iron 12" below the pavement surface. No OCRC witnesses are standing. I believe the 1" sq. iron to be the OCRC monument mentioned above. No evidence is known to me to indicated that the corner would be in any other location. This 1/2" Iron IS ACCEPTED AS A CAREFUL AND FAITHFUL PERPETUATION OF THE POSITION OF THE ORIGINAL CORNER.

C. Description of monument for corner and accessories established to perpetuate locating the position of the corner.

I-9 CORNER COMMON TO SECTIONS 22, 23, 26 & 27 T14N, R15W, NEWFIELD TWP

Set 5/8"x24" Iron with cast aluminum cap stamped "Oceana County Remonumentation" and "26457" in place of found 1/2" Iron

PK Nail SW Face Power Pole 321°az 62.35 EDM

60D spk W Face 8" Oak 16°az 97.31' EDM

PK Nail E Face wood Fence Post 190°az 214.27 EDM


Steel Buried Telephone Line Post 285°az 69.7 EDM

PK nail S Face 4x4 Wood Fence Post 260°az 167.19 EDM

Oceana County Remonumentation  
Peer Group Reviewed & Approved

Date: 8-18-94

*JRH*  
J. Randolph Hepworth

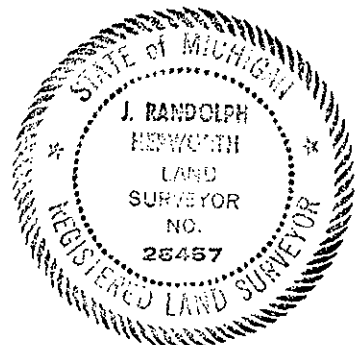

Signed by *J. Randolph Hepworth*

Date December 5, 1996

Surveyor's Michigan License No. 26457