

**SURVEY & REMONUMENTATION**

**FEB 02 1998**

**100820**

**SECTION**

**LAND CORNER RECORDATION CERTIFICATE**  
Filing Requirement of Act 74, Mich. P.A. 1970

For corners in  
Oceana

Located In: Corner Code #

1. Public Land Survey

T14N	R17W	M-9
T14N	R16W	A-9
T	R	
T	R	
S	T	R
S	T	R
S	T	R
S	T	R

2. Property Controlling in Section

3. Miscellaneous Property in Sec.

STATE OF MICHIGAN  
COUNTY OF OCEANA  
RECEIVED FOR RECORD

14 Jan 1998 9:36:12 AM

JOSEPH E. MERTEN  
REGISTER OF DEEDS

Register of Deeds Stamp & File Number

4. Lot No. \_\_\_\_\_, Recorded Plat \_\_\_\_\_  
5. Private Claims \_\_\_\_\_

I, J. Randolph Hepworth in a field survey on July 24, 1997 do hereby state that under requirements of P.A. 74, Michigan P.A. of 1970, the corner points mentioned in lines 1 and 2 above were in conformance with regulations and rules therefore as required in the current manual of survey instructions of the United States Department of the Interior, Bureau of Land Management or by a decree of a Court of Law and for that the corner points mentioned in lines 3, 4 and 5 above were in conformance with the rules of the Michigan Board of Land Surveyors or by a Decree of a Court of Law; established, re-established, monumented, recovered, found as expressed below:

NOTE: Not more than 2 corners, all in the same town and range, may be recorded on this certificate.

	A	B	C	D	E	F	G	H	I	J	K	L	M
1													
2	6		5		4		3		2		1		
3													
4	7		8		9		10		11		12		
5													
6	18		17		16		15		14		13		
7													
8	19		20		21		22		23		24		
9													
10	30		29		28		27		26		25		
11													
12	31		32		33		34		35		36		
13													

A. Description of original monument and accessories and/or subsequent restoration:

M-9 CORNER COMMON TO SECTIONS 24 & 25 T14N, R17W SHELBY TOWNSHIP  
A-9 CORNER COMMON TO SECTIONS 19 & 30 T14N, R16W FERRY TOWNSHIP

GLO Set post 10" Maple for post cor. sect. 24 and 25  
Book C, Pg 86; H. Salisbury, 1914; Corner not described or witnessed.  
Book C, Pg 84; H. Salisbury, 1914; "Oak stake and crockery from which  
5"Oak S10°W 29.7' 6"Oak N45°W 31.7'."  
Book C, Pg 166; E. Hyde, date unknown, "Post from which 5" W. Oak N43°W 42.9'  
5" W. Oak S18°W 11.8'."

Date: 10-16-97  
JRH  
J. Randolph Hepworth  
Oceana County Surveyor

B. Description of corner evidence found and/or method applied in restoring or reestablishing corner.


I found a 1/2" Iron & cap "HEI 14091" on an E-W & S old fence line intersection remnants. A row of stones piled runs to the west and ends at the iron & fence intersection. Upon excavation, I found several pieces of broken crockery, but did not notice any remnants of the Salisbury Oak Stake. One possible Hyde witness is standing at N45°W 45'.

This represents the best available evidence for the position of the corner. This corner is accepted as a careful and faithful perpetuation of the position of the original corner. No evidence is known to me that would lead me to believe that the corner should be at another location. I placed a 4"x20" Harrison Cast Iron Monument stamped "County Surveyor" and "26457" above the 1/2" Iron which was driven down. I placed a circle of stones around the set monument.

C. Description of monument for corner and accessories established to perpetuate locating the position of the corner.

M-9 CORNER COMMON TO SECTIONS 24 & 25 T14N, R17W SHELBY TOWNSHIP  
A-9 CORNER COMMON TO SECTIONS 19 & 30 T14N, R16W FERRY TOWNSHIP  
Set "County Surveyor" Harrison 4"x20" Cast Iron Monument

60d spk	SW Face	18" W Oak	315°az	45.11	EDM
60d spk	E Face	14" W Oak	195°az	30.36	EDM
60d spk	NW Face	14" Maple	50°az	30.82	EDM
60d spk	SW Face	12" W Oak	125°az	59.60	EDM
	centerline of E-W Trail Road		South	6 feet	

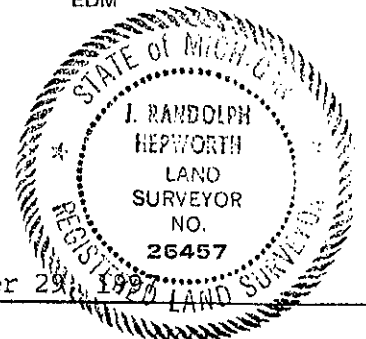

Signed by J. Randolph Hepworth  
Surveyor's Michigan License No. 26457

Date November 29, 1997