

SURVEY & REMONUMENTATION

FEB 02 1998

SECTION

LAND CORNER RECORDATION CERTIFICATE
Filing Requirement of Act 74, Mich. P.A. 1970

STATE OF MICHIGAN
COUNTY OF OCEANA
RECEIVED FOR RECORD

14 Jan 1998 9:31:32 AM

For corners in

Oceana

(County)

Located In:

Corner Code #

1. Public Land Survey

T 14N R 16W

G-8

T	R	_____
T	R	_____
T	R	_____
T	R	_____
T	R	_____
T	R	_____
T	R	_____
T	R	_____

2. Property Controlling in Section

S _____
S _____

T _____
T _____

3. Miscellaneous Property in Sec.

S _____
S _____

T _____
T _____

JOSEPH E. MERTEN
REGISTER OF DEEDS

100800

Register of Deeds Stamp & File Number

4. Lot No. _____, Recorded Plat _____

5. Private Claims _____

J. Randolph Hepworth

April 4 97

I, _____, in a field survey on _____, 19____ do hereby state that under requirements of P.A. 74, Michigan P.A. of 1970, the corner points mentioned in lines 1 and 2 above were in conformance with regulations and rules therefore as required in the current manual of survey instructions of the United States Department of the Interior, Bureau of Land Management or by a decree of a Court of Law and /or that the corner points mentioned in lines 3, 4 and 5 above were in conformance with the rules of the Michigan Board of Land Surveyors or by a Decree of a Court of Law; established, re-established, monumented, recovered, found as expressed below:

NOTE: Not more than 2 corners, all in the same town and range, may be recorded on this certificate.

A	B	C	D	E	F	G	H	I	J	K	L	M
1												
2	6		5		4		3		2		1	
3												
4	7		8		9		10		11		12	
5												
6	18		17		16		15		14		13	
7												
8	19		20		21		22		23		24	
9												
10	30		29		28		27		26		25	
11												
12	31		32		33		34		35		36	
13												

A. Description of original monument and accessories and/or subsequent restoration:

G-8 1/4 CORNER COMMON TO SECTIONS 21 & 22 T14N, R16W FERRY TOWNSHIP

GLO Set Post 18" Beech N36°W 13.9' 30" Beech S53°E 27.7'

Book A, S. Edson, 1879; Corner not described or witnessed.

Book A, H.A. Grant, 1896; "Wagon Skein fr wh 30" Pine Stump N41°E 26.1' 24" Pine Stump S50°E 48.2'

Consumers Power Co, Salisbury & Sanders, 1966, Fd Wagon Skein
Pine Stump N60°W 72.1' 4" Red Pine N35°E 35.8'
4" Red Pine N10°E 20.5' Cor Fence Post N45°E 1.5'

Oceana County Remonumentation
Per: Group Reviewed & Approved
Date: 10-16-97

J. Randolph Hepworth
Oceana County Surveyor

B. Description of corner evidence found and/or method applied in restoring or reestablishing corner.

I found an old wagon skein at the surface of the ground at the intersection of old fence lines (lying down) E-W & N. The well-rotted remains of a pine stump was found at N41°E 27'. This corner is as described by Grant, 1896 and by C.P. Co., 1967.

This iron was accepted as the best evidence of the corner and was accepted as being a careful and faithful perpetuation of the original corner. No evidence is known to me that would lead me to believe that the corner should be in another location.

I lowered the wagon skein and placed a 4"x20" Harrison Cast Iron Monument stamped "County Surveyor" and "26457" above it to 4" below the surface of the ground.


C. Description of monument for corner and accessories established to perpetuate locating the position of the corner.

G-8 1/4 CORNER COMMON TO SECTIONS 21 & 22 T14N, R16W FERRY TOWNSHIP

4"x20" Harrison Cast Iron Monument stamped "County Surveyor" and "26457"

Well rotted Pine Stump Cen 290°AZ 77' +/-

60d Spk	SE Face	3" Pine	243°AZ	4.39'	Tape
60d Spk	SW Face	8" Pine	129°AZ	12.79'	Tape
60d Spk	E Face	12" Pine (CPCo)	13°AZ	22.53'	Tape
60d Spk	NW Face	12" Pine (CPCo)	50°AZ	35.81'	Tape
60d Spk	SW Face	8" Cherry	299°AZ	75.47'	Tape

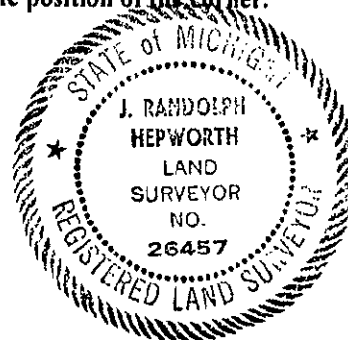

Signed by J. Randolph Hepworth
Surveyor's Michigan License No. 26457

Date November 29, 1997