

SURVEY & REMONUMENTATION

FEB 02 1998

SECTION

LAND CORNER RECORDATION CERTIFICATE
Filing Requirement of Act 74, Mich. P.A. 1970

100806

For corners in

<u>Oceana</u> (County)	Located In:	Corner Code #
1. Public Land Survey	T14N R17W	I-5
	T_____ R_____	_____
	T_____ R_____	_____
	T_____ R_____	_____
2. Property Controlling in Section	S_____ T_____ R_____	_____
	S_____ T_____ R_____	_____
3. Miscellaneous Property in Sec.	S_____ T_____ R_____	_____
	S_____ T_____ R_____	_____

STATE OF MICHIGAN
COUNTY OF OCEANA
RECEIVED FOR RECORD

14 Jan 1998 9:32:59 AM

JOSEPH E. MERTEN
REGISTER OF DEEDS

Register of Deeds Stamp & File Number

4. Lot No. _____, Recorded Plat _____
5. Private Claims _____

J. Randolph Hepworth June 27 97
I, _____, in a field survey on _____, 19____ do hereby state that under requirements of P.A. 74, Michigan P.A. of 1970, the corner points mentioned in lines 1 and 2 above were in conformance with regulations and rules therefore as required in the current manual of survey instructions of the United States Department of the Interior, Bureau of Land Management or by a decree of a Court of Law and /or that the corner points mentioned in lines 3, 4 and 5 above were in conformance with the rules of the Michigan Board of Land Surveyors or by a Decree of a Court of Law; established, re-established, monumented, recovered, found as expressed below:

NOTE: Not more than 2 corners, all in the same town and range, may be recorded on this certificate.

A	B	C	D	E	F	G	H	I	J	K	L	M
1												
2	6	5	4	3	2	1						
3												
4	7	8	9	10	11	12						
5												
6	18	17	16	15	14	13						
7												
8	19	20	21	22	23	24						
9												
10	30	29	28	27	26	25						
11												
12	31	32	33	34	35	36						
13												

A. Description of original monument and accessories and/or subsequent restoration:

I-5 CORNER COMMON TO SECTIONS 10, 11, 14, & 15 T14N, R17W

GLO Set post 12"Beech N47°E 6.6' 10"Beech N31°W 12.5'
Book A, Pg 28; H. Hawley, 1876. "... North East Corner of sec corner a Sleighshoe driven a
Book A, Pg 348; H. Salisbury, 1879: Corner not described or witnessed


Recorded Survey, JKT # 152, Rupert Jackson # 11362, 7/15/75, PK Nail
18" Maple 29.7' NE
12" Tree 42.4' NW
48" Maple 55.4' SW

Unrecorded Survey, K. Ross #17634, 10-17-77, Ex. 1/2" IR
12"Walnut NW 42.24' 18" Maple NE 30.33' 40" Maple SW 54.90'

Unrecorded Survey, JR Hepworth #26457, 10/29/92, Fd 1/2" Iron
Rd Name sign 231°AZ 47.33' EDM Buried Cable sign 211°AZ 62.2' EDM
Buried Cable sign 151°AZ 66.4' EDM 18" Maple 49°AZ 30.34' EDM
16" Walnut 317°AZ 42.19' EDM

SHELBY TOWNSHIP

little below the surface..."

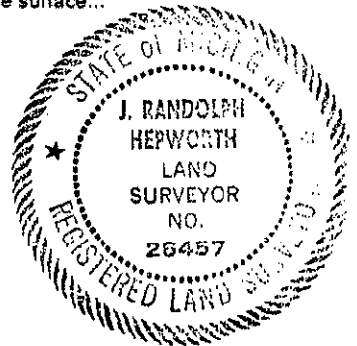

B. Description of corner evidence found and/or method applied in restoring or reestablishing corner.

I found a 1/2" Iron at the surface and in the centerline intersection of E-W-S asphalt road and gravel road to North. R. Jackson, LS11362, found or set a PK Nail with witnesses substantially the same as Ross in 1977. Upon excavation the 1/2" iron was found to be 12" long. Upon further excavation to 24" below the surface, a metal object was detected further down and centered in the hole. Road intersection could be in as much as 4 feet of fill above original ground grade. I did not dig further as I believe evidence is sufficient to accept the corner as found.

This represents the best available evidence for the position of the corner. The found 1/2" Iron is accepted as a careful and faithful perpetuation of the position of the original corner. No evidence is known to me that would lead me to believe that the corner should be at another location. I placed a 4"x20" Harrison Cast Iron Monument stamped "County Surveyor" and "26457" at the position found.

C. Description of monument for corner and accessories established to perpetuate locating the position of the corner.

I-5 CORNER COMMON TO SECTIONS 10, 11, 14, & 15 T14N, R17W SHELBY TOWNSHIP

"County Surveyor" Harrison 4"x20" Cast Iron Monument

centerline of road intersection	N-S-E-W				
60d spk NW Face	21" Maple	49°az	30.46	EDM	
60d spk NE Face	21" Walnut	317°az	42.08	EDM	
60d spk SE Face	6" tw Basswood	223°az	60.66	EDM	
center	4" Maple	76°az	118.13	EDM	

Oceana County Remonumentation
Peer Group Reviewed & Approved

Date: 10-16-97

JRH
J. Randolph Hepworth
Oceana County Surveyor

Signed by J. Randolph Hepworth
Surveyor's Michigan License No. 26457

Date November 29, 1997