

**SURVEY & REMONUMENTATION**

FEB 02 1998

100808

**SECTION**

**LAND CORNER RECORDATION CERTIFICATE**  
Filing Requirement of Act 74, Mich. P.A. 1970

For corners in  
Oceana  
(County)

Located in:

Corner Code #

1. Public Land Survey	T	14N	R	17W	I-9
	T		R		
	T		R		
	T		R		
2. Property Controlling in Section	S		T	R	
	S		T	R	
3. Miscellaneous Property in Sec.	S		T	R	
	S		T	R	

STATE OF MICHIGAN  
COUNTY OF OCEANA  
RECEIVED FOR RECORD

14 Jan 1998 9:33:27 AM

JOSEPH E. MERTEN  
REGISTER OF DEEDS

Register of Deeds Stamp & File Number

4. Lot No. \_\_\_\_\_, Recorded Plat \_\_\_\_\_  
5. Private Claims \_\_\_\_\_

J. Randolph Hepworth, in a field survey on June 27, 1997 do hereby state that under requirements of P.A. 74, Michigan P.A. of 1970, the corner points mentioned in lines 1 and 2 above were in conformance with regulations and rules therefore as required in the current manual of survey instructions of the United States Department of the Interior, Bureau of Land Management or by a decree of a Court of Law and/or that the corner points mentioned in lines 3, 4 and 5 above were in conformance with the rules of the Michigan Board of Land Surveyors or by a Decree of a Court of Law; established, re-established, monumented, recovered, found as expressed below:

NOTE: Not more than 2 corners, all in the same town and range, may be recorded on this certificate.

	A	B	C	D	E	F	G	H	I	J	K	L	M
1													
2	6		5		4		3		2		1		
3													
4	7		8		9		10		11		12		
5													
6	18		17		16		15		14		13		
7													
8	19		20		21		22		23		24		
9													
10	30		29		28		27		26		25		
11													
12	31		32		33		34		35		36		
13													

A. Description of original monument and accessories and/or subsequent restoration:

**I-9 CORNER COMMON TO SECTIONS 22, 23, 26, & 27 T14N, R17W SHELBY TOWNSHIP** County Remonumentation Peer Group Reviewed & Approved

GLO Set post 8" Birch N59°E 6.6' 12" Birch S28°W 5.3'  
Book A, pg 280; H. Grant, 1891; Corner not described or witnessed.

Date: 10-16-97

Unrecorded Survey, JR Hepworth #26457, 11/17/81, Fd 1" Pipe

J. Randolph Hepworth  
Oceana County Surveyor


B. Description of corner evidence found and/or method applied in restoring or reestablishing corner.  
I found a 3/4" ID Pipe in the centerline intersection of gravel roads E-W & S and on old occupation line to the North. Upon excavation, I found this Pipe to be inside and surrounded by a leaf-spring assembly lying flat (appears to be quite old and I am guessing it to be from an old wagon, buggy or possibly an old automobile) that is 36" long, 1 1/2" wide and 9" between the double leaf assembly. Upon removal of the Pipe, it was found to be 3.5 feet long. No other corner monumentation was found.

This represents the best available evidence for the position of the corner. The found 3/4" Pipe is accepted as a careful and faithful perpetuation of the position of the original corner. No evidence is known to me that would lead me to believe that the corner should be at another location. I placed a 4"x20" Harrison Cast Iron Monument stamped "County Surveyor" and "26457" above the Pipe which was driven down. I laid the leaf-spring assembly back around the Harrison as I had found it.

C. Description of monument for corner and accessories established to perpetuate locating the position of the corner.

**I-9 CORNER COMMON TO SECTIONS 22, 23, 26, & 27 T14N, R17W SHELBY TOWNSHIP**  
"County Surveyor" Harrison 4"x20" Cast Iron Monument

60d spk	NW Face	6" Sassafras	63°az	43.73	EDM
60d spk	SW Face	24" Cottonwood	155°az	44.80	EDM
60d spk	NW Face	6" R Pine	200°az	88.54	EDM
60d spk	W Face	40" Cottonwood	167°az	109.20	EDM
60d spk	N Face	8" tw Cherry	108°az	70.65	EDM

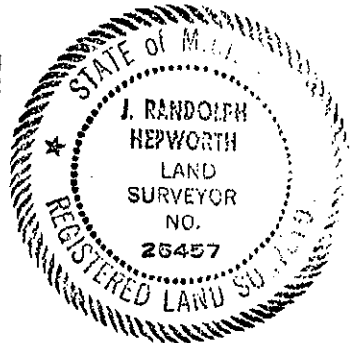

Signed by J. Randolph Hepworth  
Surveyor's Michigan License No. 26457

Date November 29, 1997