

SURVEY & REMONUMENTATION

OCT 27 1993

COMMISSION

**OCEANA COUNTY REMONUMENTATION
LAND CORNER RECORDATION CERTIFICATE
Filing Requirement of Act 74, Mich. P.A. 1970**

STATE OF MICHIGAN
COUNTY OF OCEANA
RECEIVED FOR RECORD
100498
'93 OCT -7 P2:44

Janet E. Martin
REGISTER OF DEEDS

For corners in OCEANA (County)	Located In:	Corner Code #
1. Public Land Survey	T 14N R 18W	K-11
	T _____ R _____	_____
	T _____ R _____	_____
	T _____ R _____	_____
2. Property Controlling in Section	S _____ T _____ R _____	_____
	S _____ T _____ R _____	_____
3. Miscellaneous Property in Sec.	S _____ T _____ R _____	_____
	S _____ T _____ R _____	_____

Register of Deeds Stamp & File Number

4. Lot No. _____, Recorded Plat _____
5. Private Claims _____

	A	B	C	D	E	F	G	H	I	J	K	L	M
2	6	5	4	3	2	1							
3													
4	7	8	9	10	11	12							
5													
6	18	17	16	15	14	13							
7													
8	19	20	21	22	23	24							
9													
10	30	29	28	27	26	25							
11													
12	31	32	33	34	35	36							
13													

I, J. Randolph Hepworth, in a field survey on September 30, 1993, do hereby certify that under requirements of P.A. 74, Michigan P.A. of 1970, the corner points mentioned in lines 1 and 2 above were in conformance with regulations and rules therefore as required in the current manual of survey instructions of the United States Department of the Interior, Bureau of Land Management or by a decree of a Court of Law and/or that the corner points mentioned in lines 3, 4 and 5 above were in conformance with the rules of the Michigan Board of Land Surveyors or by a Decree of a Court of Law; established, re-established, monumented, re-monumented, recovered, found as expressed below:

NOTE: Not more than 4 corners, all in the same town and range, may be recorded on this certificate.

A. Description of original monument and accessories and/or subsequent restoration:

K-11 CORNER COMMON TO SECTIONS 25, 26, 35, AND 36 BENONA TWP; T14N, R18W
GLO SET POST 10" BEECH S42°E 16.5' 20" BEECH N45°E 23.8' STREAM SOUTH 297'
BOOK A-66 EDSON, 1880 ROUGH, GRAY STONE 7X5X15 POINT UP FLAT SIDES FACE N&S
BOOK A-276 GRANT, 1891 STONE
OCRC WITNESS: POINTED STONE W/ 1/2" IRON ON TOP
18" ELM S60°E 34.2' 18" ELM S45°W 61.3' 18" ELM N50°W 71.0'


B. Description of corner evidence found and/or method applied in restoring or reestablishing corner

FOUND GRAY STONE 7X5X15 WITH POINT UP, FLAT ON SE, SW & N SIDES.
BELIEVE TO BE STONE BY EDSON, 1880; STREAM IS SOUTH 293' N/L; SET 1/2"X2' IRON OVER POINT OF STONE; AND IS ACCEPTED AS A CAREFUL AND FAITHFUL PERPETUATION OF THE POSITION OF THE ORIGINAL CORNER.

C. Description of monument for corner and accessories established to perpetuate locating the position of the corner.

K-11 CORNER COMMON TO SECTIONS 25, 26, 35, AND 36
SET "COUNTY SURVEYOR" HARRISON 4"X20" CAST IRON MONUMENT IN PLACE OF FOUND STONE.

CENTER OF N - S GRAVEL ROAD			
60d SPK SW FACE	8" CHERRY	N50°W	41.89 TAPED
60d SPK SW FACE	6" ASH	N35°W	57.63 TAPED
60d SPK SE FACE	24" BASSWOOD	N90°W	25.84 TAPED
60d SPK SE FACE	20" BASSWOOD S30°W		54.15 TAPED
STREAM CROSSING	SOUTH	293'	

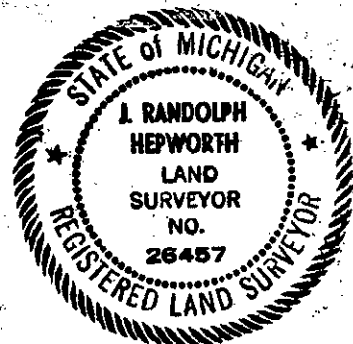

Signed by J. Randolph Hepworth
Surveyor's Michigan License No. 26457

Date October 6, 1993

11-5-93