

LAND CORNER RECORDATION CERTIFICATE

FILING REQUIREMENT OF ACT 74, MICH. P.A.1970

FOR CORNERS OF--	LOCATED IN--	CORNER CODE NUMBER
1. PUBLIC LAND SURVEY	T. 15 N. R. 18 W.	G-1; G-2; I-3
2. PROPERTY CONTROLLING IN SECTION	T. N. S. R. E. W.	
3. MISCELLANEOUS PROPERTY IN SECTION	T. N. S. R. E. W.	
4. LOT NO. _____, RECORDED PLAT _____		
5. PRIVATE CLAIMS _____		

REGISTER OF DEEDS STAMP AND FILING NUMBER

I, Carl F. Roser, do hereby certify that under requirements of P.A. 74, Michigan P.A. of 1970, the corner points mentioned in lines 1 and 2 above were, in a field survey on Aug. 30, 1978, established, re-established, monumented, re-monumented, recovered or restored as expressed below and in conformance with regulations and rules therefore as required in the current manual of survey instructions of the United States Department of the Interior, Bureau of Land Management or by a decree of a court of law. Furthermore, that the corner points mentioned in lines 3, 4 and 5 above were, in a field survey on _____, 19____, found, recovered, restored, established or re-established as expressed below and in conformance with the rules of the Michigan State Board of Registration for Land Surveyors or, by a Decree of a Court of law:

A. Description of original monument and accessories and/or subsequent restoration:

B. Description of corner evidence found and/or method applied in restoring or re-establishing corner:

- G-1 Fd. 1" round iron for Sec. Cor. Comm. to Sec's. 3 & 4, T15N-R18W and Sec's. 33 & 34, T16N-R18W. Note: S. Barnett has this Cor. Wit. & recorded, in error, as the W 1/4 Cor. Sec. 34 (G-12), T16N-R18N.
- G-2 Re-established 1/4 Cor. at pro-rated distance to U.S. between SW Cor. Sec. 3 and N 1/8 Cor. on W. Line Sec. 3. See Land Cor. Record, Item 2, Sec. 3, Code 3.
- I-3 Re-established Sec. Cor. at double distance across 1/8 line & 1/4 line fences to West, in line with old fence remains to West & in line with approx. ctr. of overgrown remains of real old road grade to North. This position agrees with cor. location as best remembered by Walter Walsworth (75 yrs.+) & Axel Johnson who has lived on adjoining 40 ac. for

C. Description of monument for corner and accessories established to perpetuate locating the position of the corner: 30 years±.

G-1	I-3	G-2
Fd. 1" round iron; added	Set 5/8"X40" Rod w/RLS Cap	Set DNR Mon & Ced. Post
Ced. Post w/Loc. tag.	9" Willow N10°E 27.65	5" Hemlock N60°W 13.9
9" Maple N30°E 27.02	Power Pole N30°E 61.00	6" Maple N30°E 5.2
fd. 4" Conc. Mon. S45°W 46.64	Set Ced. Post	4" Maple S60°E 8.7
20° W. Pine N50°W 68.75	w/Loc. Tag Due W 33'	Ctr. N-S Due W 127'
	Ctr. Rd. S'ly Due W 3'+	Trail
	Ctr. Rd. E'ly Due N 10'+	

SIGNED BY Carl F. Roser 10-2-78 DATE _____

SURVEYOR'S MICHIGAN REGISTRATION NO. 12028


FOR STATE AND UNITED STATES AGENCIES:

SIGNED BY _____ DATE _____

CHIEF OF SURVEY PARTY

APPROVED AND SIGNED BY _____ DATE _____

MICHIGAN REGISTERED LAND SURVEYOR

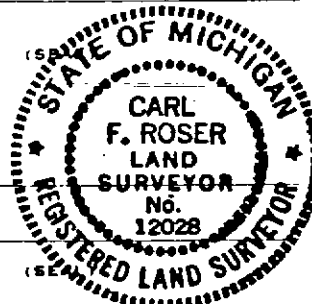

SURVEYOR'S MICHIGAN REGISTRATION NO. _____ GOLDEN TOWNSHIP
OCEANA COUNTY