

SURVEY & REMONUMENTATION

OCT 27 1993

COMMISSION

**OCEANA COUNTY REMONUMENTATION
LAND CORNER RECORDATION CERTIFICATE
Filing Requirement of Act 74, Mich. P.A. 1970**

STATE OF MICHIGAN
COUNTY OF OCEANA
RECEIVED FOR RECORD

100511

'93 OCT -7 P2:45

For corners in
OCEANA

(County)

Located In:

Corner Code #

- | | | | |
|------------------------------------|-------|-------|------|
| 1. Public Land Survey | T 15N | R 18W | E-10 |
| | T | R | |
| | T | R | |
| | T | R | |
| 2. Property Controlling in Section | S | T | R |
| | S | T | R |
| 3. Miscellaneous Property in Sec. | S | T | R |
| | S | T | R |

Joseph E. Mertens
REGISTER OF DEEDS

Register of Deeds Stamp & File Number

4. Lot No. _____, Recorded Plat _____
5. Private Claims _____

	A	B	C	D	E	F	G	H	I	J	K	L	M
2	6		5		4		3		2		1		
3													
4	7		8		9		10		11		12		
5													
6	18		17		16		15		14		13		
7													
8	19		20		21		22		23		24		
9													
10	30		29		28		27		26		25		
11													
12	31		32		33		34		35		36		
13													

J. Randolph Hepworth September 27, 1993

I, _____, in a field survey on _____, 19____, do hereby certify that under requirements of P.A. 74, Michigan P.A. of 1970, the corner points mentioned in lines 1 and 2 above were in conformance with regulations and rules therefore as required in the current manual of survey instructions of the United States Department of the Interior, Bureau of Land Management or by a decree of a Court of Law and/or that the corner points mentioned in lines 3, 4 and 5 above were in conformance with the rules of the Michigan Board of Land Surveyors or by a Decree of a Court of Law; established, re-established, monumented, re-monumented, recovered, found as expressed below:

NOTE: Not more than 4 corners, all in the same town and range, may be recorded on this certificate.

A. Description of original monument and accessories and/or subsequent restoration:

A. E-10 1/4 CORNER COMMON TO 28 & 29 GOLDEN TWP; T15N, R18W
GLO SET POST 18" HEMLOCK S55°W 11.2'
BOOK A- 364 HA GRANT, MAY, 1894 1"x22" IRON BOLT NO WITNESSES RECITED
OCRC WITNESS: FORD AXLE SET ON TOP OF OLD WOOD STAKE-PRE-1950
16" PINE S15°W 63.7 6" PINK S40°E 49.0
LCRC NO: 100159 S. BARNETT, RLS 16923, 11-21-73
FB 1/2" IRON 1.5' S OF C/L PVMT
18" POPLAR N09°E 26.45
26" MAPLE S02°W 59.73
TEL POLE S72°E 102.92
POWER POLE N39°W 74.31
ACT 132 SURVEY: JACKET #106: S. BARNETT, 11-21-73

B. Description of corner evidence found and/or method applied in restoring or reestablishing corner


FOUND 1/2" IRON AS PER LCRC #100159 AND IS ACCEPTED AS A CAREFUL AND FAITHFUL PERPETUATION OF THE POSITION OF THE ORIGINAL CORNER.

C. Description of monument for corner and accessories established to perpetuate locating the position of the corner.

E-10 1/4 CORNER COMMON TO 28 & 29; T15N, R18W
SET "COUNTY SURVEYOR" HARRISON 4"x20" CAST IRON MONUMENT IN PLACE OF FOUND 1/2" IRON.

C/L E-W PVMT ROAD	N 1.5'			
60d SPK	W FACE	24" POPLAR	N09°E	26.14
PK NAIL	SW FACE	POWER POLE	N38°W	74.45
60d SPK	N FACE	36" MAPLE	S78°W	116.96
60d SPK	E FACE	24" MAPLE	S01°W	59.69
SE COR HOUSE SIDING			N29°E	160.9

Signed by *J. Randolph Hepworth*
Surveyor's Michigan License No. 26457

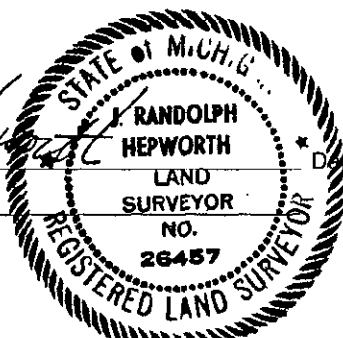

Date September 30, 1993

11-5-93