

STATE OF MICHIGAN
 COUNTY OF OCEANA
 RECEIVED FOR RECORD

3 DEC 1999 2:08:33 PM

LAND CORNER RECORDATION CERTIFICATE
 Filing Requirement of Act 74, Mich. P.A. 1970

For corners in

Oceana
 (County)

Located In: Corner Code #

- | | | |
|------------------------------------|-------------------------------------|------------|
| 1. Public Land Survey | T <u>15</u> N R <u>18</u> W | <u>F-9</u> |
| | T <u> </u> R <u> </u> | <u> </u> |
| | T <u> </u> R <u> </u> | <u> </u> |
| | T <u> </u> R <u> </u> | <u> </u> |
| 2. Property Controlling in Section | S <u> </u> T <u> </u> R <u> </u> | <u> </u> |
| | S <u> </u> T <u> </u> R <u> </u> | <u> </u> |
| 3. Miscellaneous Property in Sec. | S <u> </u> T <u> </u> R <u> </u> | <u> </u> |
| | S <u> </u> T <u> </u> R <u> </u> | <u> </u> |

JOSEPH E. MERTEN
 REGISTER OF DEEDS

100936

Register of Deeds Stamp & File Number

4. Lot No. _____, Recorded Plat _____
 5. Private Claims _____

J. Randolph Hepworth in a field survey on October 14, 1999 do hereby state that under requirements of P.A. 74, Michigan P.A. of 1970, the corner points mentioned in lines 1 and 2 above were in conformance with regulations and rules therefore as required in the current manual of survey instructions of the United States Department of the Interior, Bureau of Land Management or by a decree of a Court of Law and/or that the corner points mentioned in lines 3, 4 and 5 above were in conformance with the rules of the Michigan Board of Land Surveyors or by a Decree of a Court of Law; established, re-established, monumented, recovered, found as expressed below.

NOTE: Not more than 2 corners, all in the same town and range, may be recorded on this certificate.

	A	B	C	D	E	F	G	H	I	J	K	L	M
1													
2	6	5	4	3	2	1							
3													
4	7	8	9	10	11	12							
5													
6	10	17	16	15	14	13							
7													
8	19	20	21	22	23	24							
9													
10	30	29	28	27	26	25							
11													
12	31	32	33	34	35	36							
13													

A. Description of original monument and accessories and/or subsequent restoration:
F-9 1/4 CORNER COMMON TO SECTIONS 21 AND 28 T15N, R18W GOLDEN TOWNSHIP
 GLO J. Mullett 1838 SET POST 12" Beech N33°E (9 lks) 5.9' 10" Beech N66°W (25 lks) 16.5'
 Book A, Pg. 360, H.A. Grant, 1894; "Cedar Stake."
 Book A, Pg. 364, H.A. Grant, 1894; "See No. 15 (Book A) Page 361."
 OCRC Witness Book Pre-1950 1" Iron
 16" Basswood Due S 77.5' Cor Fence Post Due N 27.3'

Oceana County Remonumentation
 Peer Group Reviewed & Approved
 Date: 11-11-99
JRA
 J. Randolph Hepworth
 Oceana County Surveyor

B. Description of corner evidence found and/or method applied in restoring or reestablishing corner.


I found a NDA 1/2" Iron & Cap, stamped NDA & 16345, in centerline of E-W Road and on old occupation line to the north. No occupation line is visible to south across an open field. One OCRC tree witness remains and measures OK to the face of what would have been a 16" dia. Basswood, but is now 36". Upon excavation to 24", I found it to be a riser for a 3/4" ID Pipe (1" Iron?) bent over and inside a 1-1/2" Pipe at the old road bed grade. Corner is as described by OCRC.

I accept the Iron and Pipe as the best available evidence of the position of the original corner. No evidence is known to me that would lead me to believe the corner should be at another location.

C. Description of monument for corner and accessories established to perpetuate locating the position of the corner:

Set 4"x20" Harrison Cast Iron Monument, stamped "County Surveyor" and "26457" above the Iron and pipe which were driven down.

60d spk	NW Face	8" R Pine	210°az	41.00'	EDM
60d spk	E Face	36" Basswood	177°az	77.84'	EDM
60d spk	NW Face	Power Pole	69°az	109.68'	EDM
60d spk	NE Face	Power Pole	283°az	168.24'	EDM

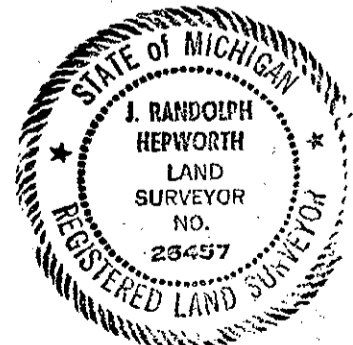

Signed by J. Randolph Hepworth
 Surveyor's Michigan License No. 26457

Date November 30, 1999