

STATE OF MICHIGAN
 COUNTY OF OCEANA
 RECEIVED FOR RECORD

3 DEC 1999 2:09:18 PM

LAND CORNER RECORDATION CERTIFICATE
 Filing Requirement of Act 74, Mich. P.A. 1970

For corners in

Oceana	Located In:	Corner Code #
(County)		
1. Public Land Survey	T <u>15N</u> R <u>18W</u>	<u>G-7</u>
	T ___ R ___	_____
	T ___ R ___	_____
	T ___ R ___	_____
2. Property Controlling in Section	S ___ T ___ R ___	_____
	S ___ T ___ R ___	_____
3. Miscellaneous Property in Sec.	S ___ T ___ R ___	_____
	S ___ T ___ R ___	_____

JOSEPH E. MERTEN
 REGISTER OF DEEDS

100939

Register of Deeds Stamp & File Number

4. Lot No. _____, Recorded Plat _____
 5. Private Claims _____

I, J. Randolph Hepworth in a field survey on October 14, 1999 do hereby state that under requirements of P.A. 74, Michigan P.A. of 1970, the corner points mentioned in lines 1 and 2 above were in conformance with regulations and rules therefore as required in the current manual of survey instructions of the United States Department of the Interior, Bureau of Land Management or by a decree of a Court of Law and/or that the corner points mentioned in lines 3, 4 and 5 above were in conformance with the rules of the Michigan Board of Land Surveyors or by a Decree of a Court of Law; established, re-established, monumented, recovered, found as expressed below:

A	B	C	D	E	F	G	H	I	J	K	L	M
1												
2	6	5	4	3	2	1						
3												
4	7	8	9	10	11	12						
5												
6	18	17	16	15	14	13						
7												
8	19	20	21	22	23	24						
9												
10	30	29	28	27	26	25						
11												
12	31	32	33	34	35	36						
13												

NOTE: Not more than 2 corners, all in the same town and range, may be recorded on this certificate.

A. Description of original monument and accessories and/or subsequent restoration:

G-7 CORNER COMMON TO SECTIONS 15, 16, 21, AND 22 T15N, R18W GOLDEN TOWNSHIP

GLO J. Mullett 1838 SET POST 10" Maple S10°E (32 lks) 21.1' 12" Hemlock S18°W (30 lks) 19.8' Book A, Pg. 198, EM Hyde, 1888; "Found two large stones one lime; the other granite, one Witness tree standing."

Book A, Pg. 360, H.A. Grant, 1894; No witnesses cited.
 Book A, Pg. 408, H.A. Grant, 1895; No witnesses cited.

Unrecorded Survey, J. R. Hepworth #26457, 2/27/84 Set JRH 1/2" Iron at old fence corner intersection
 24" Oak 284°az 2.80'
 12" Oak 352°az 37.18'
 10" Oak 55°az 32.24'
 16" Maple 110°az 25.76'

Oceana County Remonumentation
 Peer Group Reviewed & Approved

Date: 11-11-99

JRH
 J. Randolph Hepworth
 Oceana County Surveyor


B. Description of corner evidence found and/or method applied in restoring or reestablishing corner.

I found a JRH 1/2" Iron and cap at the intersection of old fence lines (lying down) E-W and N-S. A newer fence corner (estimate 10-15 years old) is standing about 4' south. This iron was found to be in a neat circle of stones. I probed in the vicinity of the corner a circle centered around the found iron about 6' in diameter and did not find any large stones that could be Hyde's.

I accept the iron as the best available evidence of the position of the original corner. No evidence is known to me that would lead me to believe the corner should be at another location.

C. Description of monument for corner and accessories established to perpetuate locating the position of the corner:

Set 4"x20" Harrison Cast Iron Monument, stamped "County Surveyor" and "26457" above the 1/2" Iron which was driven down.
 60d spk N Face 30" Oak 284°az 2.65' tape
 60d spk W Face 14" Oak 352°az 37.13' EDM
 60d spk NW Face 10" Oak 55°az 32.24' EDM
 60d spk NE Face 14" Beech 144°az 30.38' EDM

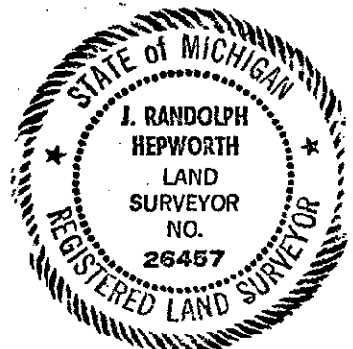

Signed by J. Randolph Hepworth
 Surveyor's Michigan License No. 26457

Date November 30, 1999