

SURVEY & REMONUMENTATION

OCT 27 1993

COMMISSION

OCEANA COUNTY REMONUMENTATION
LAND CORNER RECORDATION CERTIFICATE
Filing Requirement of Act 74, Mich. P.A. 1970

STATE OF MICHIGAN
COUNTY OF OCEANA
RECEIVED FOR RECORD

100515

'93 OCT -7 P2:46

corners in <u>OCEANA</u> (County)	Located In:	Corner Code #/
Public Land Survey	T <u>15N</u> R <u>18W</u>	<u>H-9</u>
	T _____ R _____	_____
	T _____ R _____	_____
	T _____ R _____	_____
Property Controlling in Section	S _____ T _____ R _____	_____
Miscellaneous Property in Sec.	S _____ T _____ R _____	_____

Janet E. Martin
REGISTER OF DEEDS

Register of Deeds Stamp & File Number

Lot No. _____, Recorded Plat _____
Private Claims _____

A	B	C	D	E	F	G	H	I	J	K	L	M
2	6	5	4	3	2	1						
3												
4	7	8	9	10	11	12						
5												
6	18	17	16	15	14	13						
7												
8	19	20	21	22	23	24						
9												
10	30	29	28	27	26	25						
11												
12	31	32	33	34	35	36						
13												

J. Randolph Hepworth in a field survey on September 27, 1993

hereby certify that under requirements of P.A. 74, Michigan P.A. of 1970, the corner points mentioned in lines 1 and 2 above were in conformance with regulations and rules therefore as required in the current manual of survey instructions of the United States Department of the Interior, Bureau of Land Management or by a decree of a Court of Law and/or that the corner points mentioned in lines 3, 4 and 5 above were in conformance with the rules of the Michigan Board of Land Surveyors or by a Decree of a Court of Law; established, re-established, monumented, re-monumented, recovered, found as pressed below:

NOTE: Not more than 4 corners, all in the same town and range, may be recorded on this certificate.

Description of original monument and accessories and/or subsequent restoration:

A. H-9 1/4 CORNER COMMON TO 22 & 27 GOLDEN TWP T15N, R18W
GLO- SET POST 24" BEECH S55°W 19.8'
BOOK A-382 HA GRANT, APRIL, 1895 BLUE STONE 16X8X5 NO WITNESSES RECITED
CO. ROAD COMMISSION WITNESS: PRE-1950 AXLE
20" MAPLE S60°W 41.4'
24" MAPLE S10°W 23.0'
20" OAK N45°E 40.8'
HEPWORTH WITNESSES TAKEN SEPT., 1983
FD AXLE SHAFT
30" MAPLE S60°W 41.76 STUMP ONLY
36" OAK N45°E 41.50 (GONE 7-93)
8" OAK SE 54.62
2" CHERRY S20°E 66.4 (GONE 7-93)

B. Description of corner evidence found and/or method applied in restoring or reestablishing corner


FOUND AXLE SHAFT PER OCRC WITNESSES AND IS ACCEPTED AS A CAREFUL AND FAITHFUL PERPETUATION OF THE POSITION OF THE ORIGINAL CORNER.

C. Description of monument for corner and accessories established to perpetuate locating the position of the corner.

H-9 1/4 CORNER COMMON TO 22 & 27; T15N, R18W
SET "COUNTY SURVEYOR" HARRISON 4"X20" CAST IRON MONUMENT ON TOP OF AXLE SHAFT

PK NAIL S FACE	POWER POLE	N84°W	234.16	EDM
PK NAIL S FACE	POWER POLE	N21°E	26.83	TAPE
60D SPK S FACE	POWER POLE	N84°E	270.59	EDM
60D SPK SW FACE	6" OAK	N30°W	58.04	EDM
60D SPK N FACE	16" OAK	S63°E	54.75	EDM
60D SPK SE FACE	36" MAPLE	S67°W	67.81	EDM
C/L E - W GRAVEL ROAD	SOUTH	5'		TREE LINE TO NORTH

signed by J. Randolph Hepworth
Surveyor's Michigan License No. 26457
Date September 30, 1993

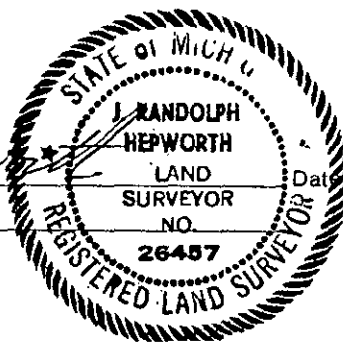

11-5-93