

LAND CORNER RECORDATION CERTIFICATE
 Filing Requirement of Act 74, Mich. P.A. 1970

3 DEC 1999 2:12:53 PM

For corners in

Oceana
 (County)

Located In:

Corner Code #

- | | | | |
|------------------------------------|---|-------------|-----|
| 1. Public Land Survey | | T 15N R 18W | I-7 |
| | | T R | |
| | | T R | |
| | | T R | |
| 2. Property Controlling in Section | S | T R | |
| | S | T R | |
| 3. Miscellaneous Property in Sec. | S | T R | |
| | S | T R | |

JOSEPH E. MERTEN
 REGISTER OF DEEDS

100944

Register of Deeds Stamp & File Number

4. Lot No. _____, Recorded Plat _____
 5. Private Claims _____

I, J. Randolph Hepworth, in a field survey on October 14, 1999 do hereby state that under requirements of P.A. 74, Michigan P.A. of 1970, the corner points mentioned in lines 1 and 2 above were in conformance with regulations and rules therefore as required in the current manual of survey instructions of the United States Department of the Interior, Bureau of Land Management or by a decree of a Court of Law and/or that the corner points mentioned in lines 3, 4 and 5 above were in conformance with the rules of the Michigan Board of Land Surveyors or by a Decree of a Court of Law; established, re-established, monumented, recovered, found as expressed below:

NOTE: Not more than 2 corners, all in the same town and range, may be recorded on this certificate.

1	A	B	C	D	E	F	G	H	I	J	K	L	M
2		6		5		4		3		2		1	
3													
4		7		8		9		10		11		12	
5													
6		18		17		16		15		14		13	
7													
8		19		20		21		22		23		24	
9													
10		30		29		28		27		26		25	
11													
12		31		32		33		34		35		36	
13													

A. Description of original monument and accessories and/or subsequent restoration:

I-7 CORNER COMMON TO SECTIONS 14, 15, 22, AND 23 T15N, R18W GOLDEN TOWNSHIP

GLO J. Mullett 1838 SET POST 15" Beech N48°E (56 lks) 37.0' 12" Beech S51°W (18 lks) 11.9'

Book A, Pg. 198, EM Hyde, 1888; "A long piece of 2 inch iron pipe 10 inch of which is above the surface."
 Book A, Pg. 298, S Edson, 1891; No witnesses cited.

OCRC Witness Book 1973 1/2 Iron Pin

- | | | |
|-------------------------------|---------------------|---------------------|
| 1) 24" Maple(Hatch?) NW 54.3' | 2) 24" Oak SE 71.2' | 3) P pole SW 113.9' |
|-------------------------------|---------------------|---------------------|

Unrecorded Survey, K. Ross #17634, 1/1977 Ex 1/2" Pipe See OCRC Witnesses

Recorded Survey, Jkt # 697, JR Hepworth #26457, 6/9/99 Fd 5/8" Iron

Oceana County Remonumentation
 Peer Group Reviewed & Approved

Date: 11-11-99

J. Randolph Hepworth
 Oceana County Surveyor

B. Description of corner evidence found and/or method applied in restoring or reestablishing corner.


I found a JRH 1/2" Iron in the centerline of N-S Road under construction. An old fence lying down runs to the east and I detected intermittent fence wire at the edge of the field lane running to the west of this iron. Upon excavation and removal, I found it to be a riser for a 5/8" Iron at 24" deep. Upon further excavation, I found the 5/8" Iron to be directly beside on the south side of a gray, granite stone about 6"x8"x8"± at original soil grade at 30" deep. I believe the 5/8" Iron is the 1/2" Pipe called for by Ross and the 1/2" Iron pin by OCRC. All 3 OCRC witnesses are standing and measure OK to the face. I did not find the Hyde, 1888, pipe.

I accept the 5/8" Iron, 1/2" Iron and stone as the best available evidence of the position of the original corner. No evidence is known to me that would lead me to believe the corner should be at another location.

C. Description of monument for corner and accessories established to perpetuate locating the position of the corner:

Set 4"x20" Harrison Cast Iron Monument, stamped "County Surveyor" and "26457" above the Irons which were driven down.

- | | | | | | |
|------------|-------------------------------------|-----------|-----------|---------|-----|
| 1) 60d spk | NE Face | 30" Maple | 330°az | 54.82' | EDM |
| 2) 60d spk | NE Face | 30" Oak | 141°az | 72.37' | EDM |
| 3) 60d Spk | SE Face | P Pole | 204°az | 113.94' | EDM |
| 60d Spk | NE Face | 3" W Pine | 313°az | 69.80' | EDM |
| 60d Spk | N Face | 8" Maple | 121°az | 73.19' | EDM |
| 60d Spk | SE Face | 5" Maple | 51°az | 76.29' | EDM |
| | Set 1/2" Iron (not on section line) | | 272°51'az | 202.14' | EDM |
| | Set 1/2" Iron (not on section line) | | 272°51'az | 100.58' | EDM |

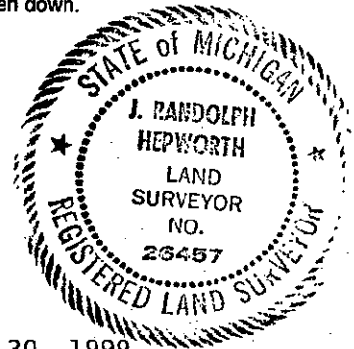

Signed by J. Randolph Hepworth
 Surveyor's Michigan License No. 26457

Date November 30, 1999