

**SURVEY & REMONUMENTATION**

OCT 27 1993

COMMISSION

STATE OF MICHIGAN  
COUNTY OF OCEANA  
RECEIVED FOR RECORD

100513

**OCEANA COUNTY REMONUMENTATION  
LAND CORNER RECORDATION CERTIFICATE**  
Filing Requirement of Act 74, Mich. P.A. 1970

'93 OCT -7 P2:46

corners in  
OCEANA

(County)

Located In:

Corner Code #

|                                 |   |     |   |     |      |
|---------------------------------|---|-----|---|-----|------|
| Public Land Survey              | T | 15N | R | 18W | I-10 |
|                                 | T |     | R |     |      |
|                                 | T |     | R |     |      |
|                                 | T |     | R |     |      |
| Property Controlling in Section | S |     | T | R   |      |
| Miscellaneous                   | S |     | T | R   |      |
| Property in Sec.                | S |     | T | R   |      |

*Joseph E. Mertens*  
REGISTER OF DEEDS

Register of Deeds Stamp & File Number

Lot No. \_\_\_\_\_, Recorded Plat \_\_\_\_\_  
Private Claims \_\_\_\_\_

|    | A  | B  | C  | D  | E  | F  | G | H | I | J | K | L | M |
|----|----|----|----|----|----|----|---|---|---|---|---|---|---|
| 2  | 6  | 5  | 4  | 3  | 2  |    |   |   |   |   |   |   |   |
| 3  |    |    |    |    |    |    |   |   |   |   |   |   |   |
| 4  | 7  | 8  | 9  | 10 | 11 | 12 |   |   |   |   |   |   |   |
| 5  |    |    |    |    |    |    |   |   |   |   |   |   |   |
| 6  | 18 | 17 | 16 | 15 | 14 | 13 |   |   |   |   |   |   |   |
| 7  |    |    |    |    |    |    |   |   |   |   |   |   |   |
| 8  | 19 | 20 | 21 | 22 | 23 | 24 |   |   |   |   |   |   |   |
| 9  |    |    |    |    |    |    |   |   |   |   |   |   |   |
| 10 | 30 | 29 | 28 | 27 | 26 | 25 |   |   |   |   |   |   |   |
| 11 |    |    |    |    |    |    |   |   |   |   |   |   |   |
| 12 | 31 | 32 | 33 | 34 | 35 | 36 |   |   |   |   |   |   |   |
| 13 |    |    |    |    |    |    |   |   |   |   |   |   |   |

J. Randolph Hepworth September 27, 1993

hereby certify that under requirements of P.A. 74, Michigan P.A. of 1970, the corner points mentioned in lines 1 and 2 above were in conformance with regulations and rules therefore as required in the current manual of survey instructions of the United States Department of the Interior, Bureau of Land Management or by a decree of a Court of Law and/or that the corner points mentioned in lines 3, 4 and 5 above were in conformance with the rules of the Michigan Board of Land Surveyors or by a Decree of a Court of Law; established, re-established, monumented, re-monumented, recovered, found as pressed below:

**NOTE: Not more than 4 corners, all in the same town and range, may be recorded on this certificate.**

Description of original monument and accessories and/or subsequent restoration:

A. I-10 1/4 CORNER COMMON TO 26 & 27 GOLDEN TWP T15N, R18W  
GLO- SET POST 10" MAPLE S60°W 8.6' 9" BEECH N31°W 7.3'

BOOK A- 366 HA GRANT; MAY, 1894 PLOW POINT  
24" PINE STUMP S40 1/2°W 45.5' 24" PINE STUMP S73 1/2°E 54.8'  
BOOK A- 382 HA GRANT; APRIL, 1895 SEE BOOK A- 366 NO WITNESSES REC'D  
CO. ROAD COMMISSION WITNESS: PRE-1950 PLOW POINT  
10" BEECH S45°45'W 30.9'  
PINE STP W/ NOTCHES S40°30'E 50.8'  
COR. PNC POST WEST 30.1'  
6" R PINE SW 29.5'  
(NO EVIDENCE FOUND OF ANY OF THESE WITNESSES 8-93)

PLAT OF 'KITCHEN'S HAPPY HOLLOW; RECORDED 1981 K. ROSS, RLS PD 1" PIPE  
Hepworth witnesses from Sept. 17, 1983 unrecorded survey


B. Description of corner evidence found and/or method applied in restoring or reestablishing corner

FOUND 1" PIPE LYING DOWN FROM ROAD CONSTRUCTION.  
RESET 1" PIPE @ PREVIOUS POSITION BY JRH WITNESSES TAKEN IN 1983  
AND IS ACCEPTED AS A CAREFUL AND FAITHFUL PERPETUATION OF THE POSITION OF THE ORIGINAL CORNER.

C. Description of monument for corner and accessories established to perpetuate locating the position of the corner.  
I-10 1/4 CORNER COMMON TO 26 & 27 GOLDEN TWP T15N, R18W

SET "COUNTY SURVEYOR" HARRISON 4"x20" CAST IRON MONUMENT ON TOP OF 1" PIPE.  
C/L GRAVEL ROAD 8' EAST  
60D SPK N FACE 8" R PINE S58°E 50.85 TAPE  
60D SPK N FACE 18" CHERRY S87°E 80.57 TAPE  
60D SPK SW FACE 5" CHERRY N45°W 23.79 TAPE  
60D SPK SE FACE 8" R PINE S48°W 32.07 TAPE  
FOUND 3/4" PIPE EAST 33.27 TAPE

Witnessed by J. Randolph Hepworth Date September 30, 1993  
Surveyor's Michigan License No. 26457

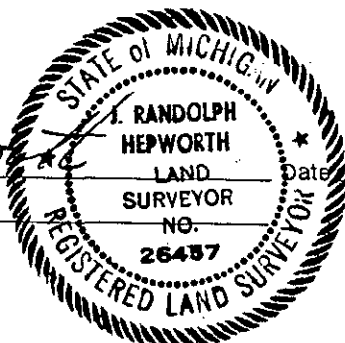

11-5-93