

SURVEY & REMONUMENTATION

OCT 27 1993

COMMISSION

OCEANA COUNTY REMONUMENTATION
LAND CORNER RECORDATION CERTIFICATE
Filing Requirement of Act 74, Mich. P.A. 1970

STATE OF MICHIGAN
COUNTY OF OCEANA
RECEIVED FOR RECORD

100512

'93 OCT -7 P2:45

For corners in

<u>OCEANA</u> (County)	Located In:	Corner Code #
1. Public Land Survey	T <u>15N</u> R <u>18W</u>	<u>J-9</u>
	T _____ R _____	_____
	T _____ R _____	_____
	T _____ R _____	_____
2. Property Controlling in Section	S _____ T _____ R _____	_____
	S _____ T _____ R _____	_____
3. Miscellaneous Property in Sec.	S _____ T _____ R _____	_____
	S _____ T _____ R _____	_____

Joseph E. Martin
REGISTER OF DEEDS

Register of Deeds Stamp & File Number

4. Lot No. _____, Recorded Plat _____
5. Private Claims _____

	A	B	C	D	E	F	G	H	I	J	K	L	M
2	6	5	4	3	2								
3													
4	7	8	9	10	11	12							
5													
6	13	17	16	15	14	13							
7													
8	19	20	21	22	23	24							
9													
10	30	29	28	27	26	25							
11													
12	31	32	33	34	35	36							
13													

J. Randolph Hepworth, in a field survey on September 27, 1993, do hereby certify that under requirements of P.A. 74, Michigan P.A. of 1970, the corner points mentioned in lines 1 and 2 above were in conformance with regulations and rules therefore as required in the current manual of survey instructions of the United States Department of the Interior, Bureau of Land Management or by a decree of a Court of Law and/or that the corner points mentioned in lines 3, 4 and 5 above were in conformance with the rules of the Michigan Board of Land Surveyors or by a Decree of a Court of Law; established, re-established, monumented, re-monumented, recovered, found as expressed below:

NOTE: Not more than 4 corners, all in the same town and range, may be recorded on this certificate.

A. Description of original monument and accessories and/or subsequent restoration:

A. J-9 1/4 CORNER COMMON TO 23 & 26 GOLDEN TWP T15N, R18W
GLO- SET POST 10" BEECH S64°W 23.8' 18" BEECH N54°E 27.1'
BOOK A- 298 HA GRANT; OCT. 1891 GRAY STONE 8X12X16 NO WITNESSES RECITED
BOOK A- 366 HA GRANT; MAY 1894 STONE PREVIOUSLY SET NO WITNESSES RECITED
CO. ROAD COMMISSION WITNESS: POINT OF LG STONE IN STONE POCKET
8" CHERRY S20°E 36.1' (GONE 7-93)
12" APPLE S45°W 52.4' (GONE 7-93)


B. Description of corner evidence found and/or method applied in restoring or reestablishing corner

FOUND 8"x12"x16" BLUE GRANITE ROCK INSIDE A CIRCLE OF SMALL STONES AND FOUND A 3/4" IRON BESIDE AND IS ACCEPTED AS A CAREFUL AND FAITHFUL PERPETUATION OF THE POSITION OF THE ORIGINAL CORNER. SET A CHISELED 'X' ON POINT OF STONE.
3/4" IRON WAS FOUND BESIDE STONE.

C. Description of monument for corner and accessories established to perpetuate locating the position of the corner.
J-9 1/4 CORNER COMMON TO 23 & 26; T15N, R18W

SET "COUNTY SURVEYOR" HARRISON 4"x20" CAST IRON MONUMENT IN PLACE OF FOUND GRANITE STONE.
C/L E-W GRAVEL ROAD
NEWER FENCE TO NORTH IS 3' EAST
60D SPK S FACE POWER POLE N51°W 56.25 EDM
60D SPK S FACE POWER POLE N82°W 308.14 EDM
60D SPK E FACE R/R TIE POST N04°E 34.06 EDM
60D SPK SE FACE 6" R PINE S28°W 197.79 EDM
FOUND 3/4" IRON 0.20' NORTH & 1.00' WEST OF CORNER

Signed by *J. Randolph Hepworth*
Surveyor's Michigan License No. 26457

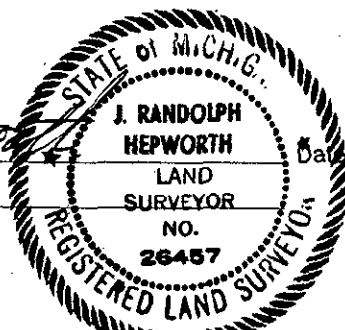

Date September 30, 1993

11-5-93