

SURVEY & REMONUMENTATION

JAN 11 1999

SECTION

LAND CORNER RECORDATION CERTIFICATE
Filing Requirement of Act 74, Mich. P.A. 1970

STATE OF MICHIGAN
COUNTY OF OCEANA
RECEIVED FOR RECORD

28 DEC 1998 4:34:36 PM

For corners in
Oceana

Located In: Corner Code #

JOSEPH E. MERTEN
REGISTER OF DEEDS

100871

		15N	15W	G-6
1. Public Land Survey	T	_____	_____	_____
	T	_____	_____	_____
	T	_____	_____	_____
	T	_____	_____	_____
2. Property Controlling in Section	S	_____	_____	_____
	S	_____	_____	_____
3. Miscellaneous Property in Sec.	S	_____	_____	_____
	S	_____	_____	_____

Register of Deeds Stamp & File Number

4. Lot No. _____, Recorded Plat _____
5. Private Claims _____

J. Randolph Hepworth Nov. 5, 1998

I, _____, in a field survey on _____, 19____ do hereby state that under requirements of P.A. 74, Michigan P.A. of 1970, the corner points mentioned in lines 1 and 2 above were in conformance with regulations and rules therefore as required in the current manual of survey instructions of the United States Department of the Interior, Bureau of Land Management or by a decree of a Court of Law and /or that the corner points mentioned in lines 3, 4 and 5 above were in conformance with the rules of the Michigan Board of Land Surveyors or by a Decree of a Court of Law; established, re-established, monumented, recovered, found as expressed below:

NOTE: Not more than 2 corners, all in the same town and range, may be recorded on this certificate.

1	A	B	C	D	E	F	G	H	I	J	K	L	M
2	6	5	4	3	2	1							
3													
4	7	8	9	10	11	12							
5													
6	18	17	16	15	14	13							
7													
8	19	20	21	22	23	24							
9													
10	30	29	28	27	26	25							
11													
12	31	32	33	34	35	36							
13													

A. Description of original monument and accessories and/or subsequent restoration:

G-6 1/4 CORNER COMMON TO SECTIONS 15 AND 16 T15N, R15W LEAVITT TOWNSHIP

GLO SET POST 6"Beech N42°E 9' 8"Beech S15°W 16'

LCRC No. 100287, R. Hepworth #26457, 4-8-81; Set PK Nail C/I N-S Road, Fence to West
P Pole N:W 83.84' P Pole SSW 158.75'

Unrecorded Survey, R. Hepworth # 26457, 11-18-95; Fd 1/2" Iron & Cap remains in C/L Rd
Fence to East

S Edge buried Tel Cable Sign 90°AZ 31.59'
60d spk in SW Face P Pole 335°AZ 78.37'
60d spk in NW Face 20" Elm 15°AZ 96.56'
60d spk in S Face P Pole 191°AZ 171.40'

Oceana County Remonumentation
Peer Group Reviewed & Approved

Date: 12-10-98

JRH
J. Randolph Hepworth
Oceana County Surveyor

B. Description of corner evidence found and/or method applied in restoring or reestablishing corner.


I found a JRH 1/2" Iron and cap in the centerline of N-S road and on old fence to East. No occupation is visible to the west. This corner was established by me in 1981 and recorded at LCRC No. 100287 using the collateral evidence of local occupation. No other history on this corner is known to me other than GLO.

I accept the 1/2" Iron as a careful and faithful re-establishment of the position of the original corner. No evidence is known to me that would lead me to believe that the corner should be at another location.

C. Description of monument for corner and accessories established to perpetuate locating the position of the corner.

Set 4"x20" Harrison Cast Iron Monument, stamped "County Surveyor" and "26457" above the 1/2" Iron which was driven down.

60d spk	W Face	8" Elm	172°az	158.81	EDM
60d spk	E Face	Power Pole	191°az	171.43	EDM
60d spk	W Face	Power Pole	335°az	78.35	EDM
60d spk	W Face	16" Elm	15°az	96.85	EDM
S. Edge of Buried Tel Cable Sign Post			90°az	31.56	EDM

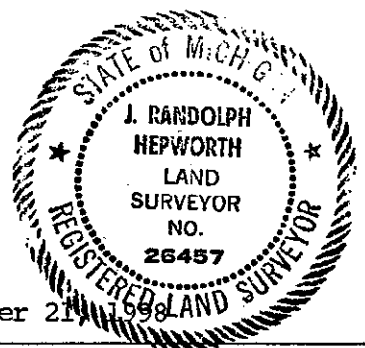

Signed by J. Randolph Hepworth
Surveyor's Michigan License No. 26457

Date December 21, 1998