

**SURVEY &
REMONUMENTATION**

FEB 25 1994

Oceana County Remonumentation
Peer Group Reviewed & Approved

Date: 11-18-93

COMMISSION

100526

J. Randolph Hepworth
Oceana County Surveyor
at corners in
OCEANA

LAND CORNER RECORDATION CERTIFICATE

Filing Requirement of Act 74, Mich. P.A. 1970

STATE OF MICHIGAN
COUNTY OF OCEANA

'93 DEC 14 A10:24

J. Randolph Hepworth
REGISTER OF DEEDS
Register of Deeds Stamp & File Number

	Located In:	Corner Code #
Public Land Survey	T <u>15N</u> R <u>15W</u>	K-9
	T _____ R _____	_____
	T _____ R _____	_____
	T _____ R _____	_____
Property Controlling in Section	S _____ T _____ R _____	_____
	S _____ T _____ R _____	_____
Miscellaneous	S _____ T _____ R _____	_____
Property in Sec.	S _____ T _____ R _____	_____

Lot No. _____, Recorded Plat _____
Private Claims _____

J. Randolph Hepworth November 23, 1993

in a field survey on _____, 19_____,
I hereby certify that under requirements of P.A. 74, Michigan P.A. of 1970, the corner points mentioned in lines 1 and 2 above were in conformance with regulations and rules therefore as required in the current manual of survey instructions of the United States Department of the Interior, Bureau of Land Management or by a decree of a Court of Law and/or that the corner points mentioned in lines 3, 4 and 5 above were in conformance with the rules of the Michigan Board of Land Surveyors or by a Decree of a Court of Law; established, re-established, monumented, re-monumented, recovered, found as expressed below:

NOTE: Not more than 4 corners, all in the same town and range, may be recorded on this certificate.

Description of original monument and accessories and/or subsequent restoration:

K-9 CORNER COMMON TO SECTIONS 23, 24, 25, AND 26 LEAVITT TWP; T15N, R15W

GLO SET POST 12" BEECH N75°W 13.2' 6" BEECH S35°W 17.2'
BOOK A-240 EM HYDE, OCT, 1889 FOUND ORIGINAL WITNESS TREES SET NEW POST
8" B ASH S58°W 40.3' 12" HEMLOCK N23°W 13.9'
BOOK C-122 HC SALISBURY 1909 CEDAR STAKE WITH 28" WELL POINT & CROCKERY IN CENTER OF ROADWAY. NO WITNESS.
OCRC WITNESS: 1 1/2" PIPE 10-6-70
COR FENCE POST S 31.75 COR FENCE POST N 32.20
REA POLE N70°E 77.05 FENCE POST N40°W 37.35
LCRC #100227 J EVANS, LS 22431 FOUND 1" PIPE
FENCE POST N 32.26 P POLE N73°E 77.02 FENCE POST S 31.74

B. Description of corner evidence found and/or method applied in restoring or reestablishing corner

FOUND 1 1/4" WELL POINT IN APPROX. CENTER OF EAST-WEST GRAVEL ROAD; OLD FENCE LINES NORTH AND SOUTH; WELL POINT FITS OCRC AND LCRC #100227 WITNESS. I believe this well point to be the Salisbury monument, although no crockery was found after excavation around this pipe. It would be reasonable to presume that Salisbury found the Hyde, 1889 corner.

The evidence is excellent to conclude that this corner position can be traced to GLO.


THIS WELL POINT IS ACCEPTED AS A CAREFUL AND FAITHFUL PERPETUATION OF THE POSITION OF THE ORIGINAL CORNER.

C. Description of monument for corner and accessories established to perpetuate locating the position of the corner.

K-9 CORNER COMMON TO SECTIONS 23, 24, 25, AND 26 LEAVITT TWP; T15N, R15W

SET "COUNTY SURVEYOR" HARRISON 4"x20" CAST IRON MONUMENT ON TOP OF FOUND WELL POINT
OLD FENCE LINES NORTH & SOUTH C/L E-W GRAVEL ROAD S 3'
80d SPK E FACE COR FENCE POST NORTH 32.38 TAPE
80d SPK W FACE COR FENCE POST SOUTH 31.93 TAPE
80d SPK SE FACE POWER POLE N70°E 77.00 TAPE
80d SPK NW FACE 8" CHERRY S85°W 67.69 TAPE

Witnessed by J. Randolph Hepworth
Surveyor's Michigan License No. 26457

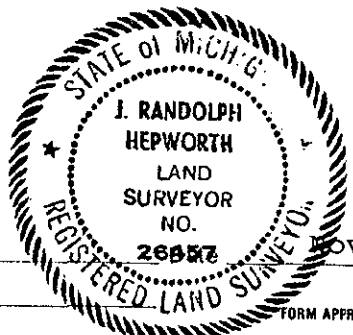

November 26, 1993

	A	B	C	D	E	F	G	H	I	J	K	L	M
2	6	5	4	3	2	1							
3													
4	7	8	9	10	11	12							
5													
6	18	17	16	15	14	13							
7													
8	19	20	21	22	23	24							
9													
10	30	29	28	27	26	25							
11													
12	31	32	33	34	35	36							
13													