SURVEY & REMONUMENTATION

FEB 25 1994

OCEANA COUNTY REMONUMENTATION COMMISSION

Oceana County Remonumentation
Peer Group Reviewed & Approved
Date: 11-18-93
JRH
J. Randolph Hepworth
Oceana County Surveyor
or corners in
OCEANA
(County)

LAND CORNER RECORDATION CERTIFICATE

Filing Requirement of Act 74, Mich. P.A. 1970

100525

STATE OF MICHIGAN
COUNTY OF OCEANA

'93 DEC 14 A10:24

REGISTER OF DEEDS

Register of Deeds Stamp & File Number

		Located In:	Corner Code #
Public Land Survey		T 15N R 15W	L-9
		T ___ R ___	
		T ___ R ___	
		T ___ R ___	
Property Controlling	S ___	T ___ R ___	
in Section	S ___	T ___ R ___	
Miscellaneous	S ___	T ___ R ___	
Property in Sec.	S ___	T ___ R ___	

Lot No. _____ , Recorded Plat _____
Private Claims _____

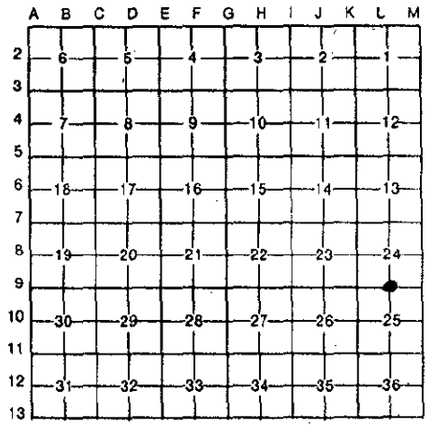

J. Randolph Hepworth November 23, 1993
_____, in a field survey on _____, 19 _____,
I hereby certify that under requirements of P.A. 74, Michigan P.A. of 1970, the corner points mentioned in lines 1 and 2 above were in conformance with regulations and rules therefore as required in the current manual of survey instructions of the United States Department of the Interior, Bureau of Land Management or by a decree of a Court of Law and/or that the corner points mentioned in lines 3, 4 and 5 above were in conformance with the rules of the Michigan Board of Land Surveyors or by a Decree of a Court of Law; established, re-established, monumented, re-monumented, recovered, found as expressed below:

NOTE: Not more than 4 corners, all in the same town and range, may be recorded on this certificate.

Description of original monument and accessories and/or subsequent restoration:

L-9 1/4 CORNER COMMON TO SECTIONS 24 AND 25 LEAVITT TWP; T15N, R15W

GLO SET POST 10" SUGAR N23°W 15.2' 8" SUGAR S75°W 16.5'
BOOK C-122 HC SALISBURY 1909 1 1/2" GAS PIPE 7" ASH N45°E 40.3'
OCRC WITNESS: BUGGY AXLE 10-6-70
REA POLE N70°E86.0 CLP APPLE S60°E 75.35 CLP ASH S40°W 65.30

B. Description of corner evidence found and/or method applied in restoring or reestablishing corner

FOUND BUGGY AXLE WITH STEERING KNUCKLE 8" FROM END PER OCRC WITNESS AND IS ACCEPTED AS A CAREFUL AND FAITHFUL PERPETUATION OF THE POSITION OF THE ORIGINAL CORNER.

DISTANCE FROM L-9 TO K-9 IS 1.3' LONGER THAN SALISBURY, 1909.

FURTHER SEARCH OF THE AREA YIELDED NO EVIDENCE OF A CONFLICTING POSTION FOR THE CORNER.

C. Description of monument for corner and accessories established to perpetuate locating the position of the corner.

L-9 1/4 CORNER COMMON TO SECTIONS 24 AND 25 LEAVITT TWP; T15N, R15W

SET "COUNTY SURVEYOR" HARRISON 4"X20" CAST IRON MONUMENT ON TOP OF FOUND BUGGY AXLE
CENTER OF GRAVEL ROAD INTERSECTION N-S & WEST

60d SPK N FACE	POWER POLE	N82°W	163.14	EDM
60d SPK S FACE	POWER POLE/TRANSF	N89°E	85.52	EDM
60d SPK SW FACE	12" B WALNUT	S24°E	55.81	EDM
60d SPK SE FACE	8" MAPLE	S57°W	85.38	EDM

STATE of MICHIGAN
J. RANDOLPH HEPWORTH
LAND SURVEYOR
NO. 26457
REGISTERED LAND SURVEYOR

Signed by J. Randolph Hepworth Date November 26, 1993
Surveyor's Michigan License No. 26457

FORM APPROVED BY MICHIGAN STATE BOARD OF LAND SURVEYORS, JAN. 28, 1971
REVISED MAY 14, 1975
REVISED JAN., 1983