

FEB 25 1994

100538

Oceana County Remonumentation Peer Group Reviewed & Approved

Date: 11-18-93

J. Randolph Hepworth
J. Randolph Hepworth
Oceana County Surveyor

OCEANA COUNTY REMONUMENTATION
LAND CORNER RECORDATION CERTIFICATE
Filing Requirement of Act 74, Mich. P.A. 1970

COMMISSION

STATE OF MICHIGAN
COUNTY OF OCEANA

corners in
OCEANA
(County)

Located In: Corner Code #


Public Land Survey	T 15N R 16W	H-7
	T R	
	T R	
	T R	
Property Controlling in Section	S T R	
Miscellaneous	S T R	
Property in Sec.	S T R	

'93 DEC 14 A10:26

J. E. Martin
REGISTER OF DEEDS

Register of Deeds Stamp & File Number

Lot No. _____, Recorded Plat _____
Private Claims _____

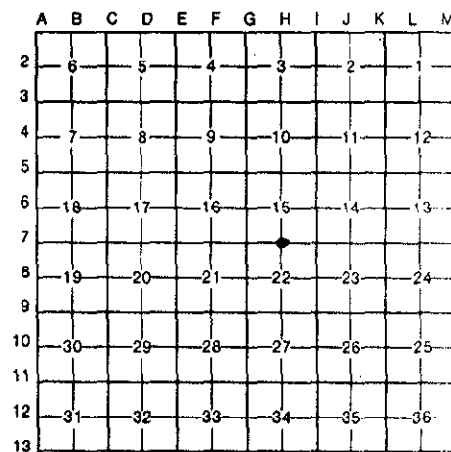

J. Randolph Hepworth in a field survey on November 22, 1993

do hereby certify that under requirements of P.A. 74, Michigan P.A. of 1970, the corner points mentioned in lines 1 and 2 above were in conformance with regulations and rules therefore as required in the current manual of survey instructions of the United States Department of the Interior, Bureau of Land Management or by a decree of a Court of Law and/or that the corner points mentioned in lines 3, 4 and 5 above were in conformance with the rules of the Michigan Board of Land Surveyors or by a Decree of a Court of Law; established, re-established, monumented, re-monumented, recovered, found as expressed below:

OTE: Not more than 4 corners, all in the same town and range, may be recorded on this certificate.

Description of original monument and accessories and/or subsequent restoration:

**A. H-7 1/4 CORNER COMMON TO SEC 15 & 22 ELBRIDGE TWP T15N, R16W
GLO 30' HEMLOCK FOR CORNER NO WITNESSES RECITED**

LCRC #100418 HEPWORTH, 4-2-82; SET 1/2" IRON, SINGLE PRORATION CENTER OF E-W ROAD
CLP 4" ASH N 40.60 4" ELM S45°W 37.79 20' COTTONWOOD S70°E 74.75

B. Description of corner evidence found and/or method applied in restoring or reestablishing corner

Found 1/2" Iron per LCRC#100418. No Occupation existed at this corner in 1982. A fence now runs North from this corner. This corner position fits measurement to the West 1/16 line occupation. East 1/16 line occupation is obliterated and indefinite.

I BELIEVE THIS 1/2" IRON PER LCRC 100418 REPRESENTS THE BEST LOCATION FOR THE CORNER GIVEN THE EVIDENCE AVAILABLE; AND IS ACCEPTED AS A CAREFUL AND FAITHFUL PERPETUATION OF THE POSITION OF THE ORIGINAL CORNER.

C. Description of monument for corner and accessories established to perpetuate locating the position of the corner.

H-7 1/4 CORNER COMMON TO SEC 15 & 22 ELBRIDGE TWP T15N, R16W

SET "COUNTY SURVEYOR" HARRISON 4"x20" CAST IRON MONUMENT IN PLACE OF FOUND 1/2" IRON

80d SRK	SE FACE	12" WILLOW	S53°W	63.47	EDM
PK NAIL	NE FACE	POWER POLE	N78°W	157.71	EDM
80d SPK	W FACE	16" ASH	N10°E	83.62	EDM
80d SPK	NW FACE	10" ASH	N38°E	87.56	EDM
80d SPK	N FACE	20" COTTONWOOD	S71°E	75.24	EDM



Signed by J. Randolph Hepworth Date November 24, 1993

Surveyor's Michigan License No. 26457