

LAND CORNER RECORDATION CERTIFICATE  
 Filing Requirement of Act 74, Mich. P.A. 1970

3 DEC 1999 2:13:47 PM

For corners in

Oceana Located In: Corner Code #  
 (County)

1. Public Land Survey T15N R17W G-6  
 T R  
 T R  
 T R

2. Property Controlling S T R  
 in Section S T R

3. Miscellaneous S T R  
 Property in Sec. S T R

JOSEPH E. MERTEN  
 REGISTER OF DEEDS

100948

Register of Deeds Stamp & File Number

4. Lot No. \_\_\_\_\_, Recorded Plat \_\_\_\_\_  
 5. Private Claims \_\_\_\_\_

J. Randolph Hepworth in a field survey on October 12, 1999 do hereby state that under requirements of P.A. 74, Michigan P.A. of 1970, the corner points mentioned in lines 1 and 2 above were in conformance with regulations and rules therefore as required in the current manual of survey instructions of the United States Department of the Interior, Bureau of Land Management or by a decree of a Court of Law and for that the corner points mentioned in lines 3, 4 and 5 above were in conformance with the rules of the Michigan Board of Land Surveyors or by a Decree of a Court of Law; established, re-established, monumented, recovered, found as expressed below:

A	B	C	D	E	F	G	H	I	J	K	L	M
1												
2	6	5	4	3	2	1						
3												
4	7	8	9	10	11	12						
5												
6	18	17	16	15	14	13						
7												
8	19	20	21	22	23	24						
9												
10	30	29	28	27	26	25						
11												
12	31	32	33	34	35	36						
13												

NOTE: Not more than 2 corners, all in the same town and range, may be recorded on this certificate.

A. Description of original monument and accessories and/or subsequent restoration:

G-6 1/4 CORNER COMMON TO SECTIONS 15 AND 16 T15N, R17W HART TOWNSHIP  
 GLO J. Mullett 1838 SET POST 8" Beech S26°E (49 lks) 32.3' 8" Beech S69°W (19 lks) 12.5'  
 Book A, Pg. 38, H. Hawley, 1878; Corner not witnessed.  
 Book A, Pg. 482, H. Salisbury, 1895; Corner not witnessed.

Oceana County Remonumentation  
 Peer Group Reviewed & Approved  
 Date: 11-11-99  
JRH  
 J. Randolph Hepworth  
 Oceana County Surveyor


OCRC Witness Book 1963 Angle Iron Fence line East & West  
 Recorded Survey, Jkt #214, J. Nelson #21273, 12/19/77 FD Angle Iron Found 1" X 1" Angle Iron in the Center of 88<sup>th</sup> Avenue (10' dirt and Gravel trail), in line with fence going East and in line with chain link fence, beginning approx. 1320' West. 1) Set Nail w/RLS Tag in North side of fence post 90°az 16.63'  
 LCRC # 100213, J. Nelson, #21273, 3/23/78 See Jkt#214  
 Unrecorded Survey, JR Hepworth #26457, 12/21/90 FD Angle Iron No Witnesses Available

B. Description of corner evidence found and/or method applied in restoring or reestablishing corner.

I found a 1"x1" angle Iron in the centerline of North-south road and on old fence line to east and field division line to the west. An E-W chain Link fence begins approx. 1320' west and on line with this corner. The only witness by Nelson is standing and in good shape and measures OK. No other witnesses are available within a reasonable distance. I found the iron to be 12" long. No other iron object was detected. Having no other historical description for the corner and finding not other corner monumentation, I accept this iron as the best evidence of the position of the original corner.  
 I accept the iron as the best available evidence of the position of the original corner. No evidence is known to me that would lead me to believe the corner should be at another location.

C. Description of monument for corner and accessories established to perpetuate locating the position of the corner:

Set 4"x20" Harrison Cast Iron Monument, stamped "County Surveyor" and "26457" above the angle iron which was driven down.  
 1) Fd Nail/tag N Face Fence Post East 16.70' EDM  
 Set 1/2" iron in ditch on E. Side of Road 162°az 60.79' EDM  
 Set 1/2" iron in ditch on W. Side of Road 200°az 59.46' EDM  
 Set 1/2" iron in ditch on W. Side of Road 342°az 63.41' EDM  
 Set 1/2" iron in ditch on E. Side of Road 14°az 64.49' EDM  
 G-5 corner north 2658.35' Nelson, PS

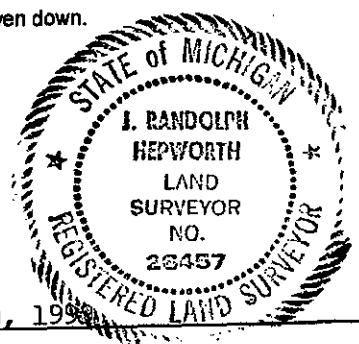

Signed by J. Randolph Hepworth  
 Surveyor's Michigan License No. 26457

Date November 30, 1999