

**SURVEY &
REMONUMENTATION**

OCT 27 1993

COMMISSION

**OCEANA COUNTY REMONUMENTATION
LAND CORNER RECORDATION CERTIFICATE
Filing Requirement of Act 74, Mich. P.A. 1970**

STATE OF MICHIGAN
COUNTY OF OCEANA
RECEIVED FOR RECORD

100508

'93 OCT -7 P2:45

For corners in

<u>OCEANA</u> (County)	Located In:	Corner Code #
1. Public Land Survey	T <u>15N</u> R <u>17W</u>	<u>J-7</u>
	T _____ R _____	_____
	T _____ R _____	_____
	T _____ R _____	_____
2. Property Controlling in Section	S _____ T _____ R _____	_____
	S _____ T _____ R _____	_____
3. Miscellaneous Property in Sec.	S _____ T _____ R _____	_____
	S _____ T _____ R _____	_____
4. Lot No. _____, Recorded Plat _____		
5. Private Claims _____		

Joseph E. Meitens
REGISTER OF DEEDS

Register of Deeds Stamp & File Number

I, J. Randolph Hepworth, in a field survey on September 27, 1993, do hereby certify that under requirements of P.A. 74, Michigan P.A. of 1970, the corner points mentioned in lines 1 and 2 above were in conformance with regulations and rules therefore as required in the current manual of survey instructions of the United States Department of the Interior, Bureau of Land Management or by a decree of a Court of Law and/or that the corner points mentioned in lines 3, 4 and 5 above were in conformance with the rules of the Michigan Board of Land Surveyors or by a Decree of a Court of Law; established, re-established, monumented, re-monumented, recovered, found as expressed below:

NOTE: Not more than 4 corners, all in the same town and range, may be recorded on this certificate.

A	B	C	D	E	F	G	H	I	J	K	L	M
2	6	5	4	3	2	1						
3												
4	7	8	9	10	11	12						
5												
6	18	17	16	15	14	13						
7												
8	19	20	21	22	23	24						
9												
10	30	29	28	27	26	25						
11												
12	31	32	33	34	35	36						
13												

A. Description of original monument and accessories and/or subsequent restoration:

A. J-7 1/4 CORNER COMMON TO SECTION 14 & 23 HART TWP T15N, R17W
 GLO SET POST 12" BEECH N42°E 29.0' 12" B ASH S48°W 16.5'
 BOOK A - 134; S. EDSON, 1882 FD GOV'T WITNESS: NO OTHER DESCRIPTION
 BOOK A - 180; EM HYDE, 1887 *FD POST CLAIMED TO BE AT ORIGINAL COR*
 BOOK C - 6; HC SALISBURY, UNDATED, FD STONE SET BY HYDE
 2" MAPLE N 28.6 2" ELM S45°W 41.5
 OCRC WITNESS BOOK: PLOW POINT UNDATED, BUT EARLY
 18" ELM S45°W 41.2 18" ELM N70°E 65.6
 1 1/4" PIPE, 1968
 18" ELM-STP N60°E 64.5 P POLE S30°E 66.0 RD SIGN N10°E 15.8
 C.P.CO., G. BLASS, LS 1967 FD 1 1/4" PIPE WITNESSES AGREE W/ OCRC
 UNRECORDED SURVEY- R. HEPWORTH, LS 26457 11-2-83 RAISED 1 1/4" PIPE WITH 1/2"x2' IRON TO SURFACE


B. Description of corner evidence found and/or method applied in restoring or reestablishing corner

FD 1/2"x 2' IRON ABOVE 1 1/4" PIPE AND IS ACCEPTED AS A CAREFUL AND FAITHFUL PERPETUATION OF THE POSITION OF THE ORIGINAL CORNER.

C. Description of monument for corner and accessories established to perpetuate locating the position of the corner.

J-7 1/4 COR. COMMON TO 14 & 23; T15N, R17W
 SET COUNTY SURVEYOR HARRISON 4"x20" CAST IRON MONUMENT IN PLACE OF FOUND 1/2" IRON AND ABOVE 1 1/4" PIPE
 CENTER OF ROAD INTERSECTION - E - W & S

PK NAIL	N FACE	POWER POLE	S60°W	70.15	TAPE
CENTER		STOP SIGN	S25°E	50.90	TAPE
PK NAIL	E FACE	POWER POLE	N05°E	66.27	TAPE
CENTER		ROAD NAME SIGN	SW	61.7	TAPE

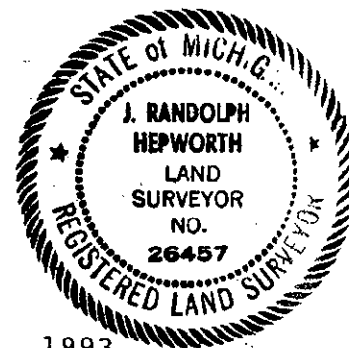

Signed by J. Randolph Hepworth Date September 30, 1993
 Surveyor's Michigan License No. 26457

11-5-93