

MICHIGAN  
DEPARTMENT OF CONSERVATION  
FORESTRY DIVISION

LAND CORNER RECORD

T. 16 N.R. 15 W


OCEANA COUNTY

DESCRIPTION OF CORNER Sec. corner common to sections 3-4 9-10

CORNER MONUMENT Fd. old 1/2" x 43" Iron rod. Added Std. Dept. Mon. & Ced. Guard Post

DATE MONUMENT PLACED AND WITNESSED April 1969

WITNESSES TO CORNER..... 8" W. Pine S 15 W 15.1'

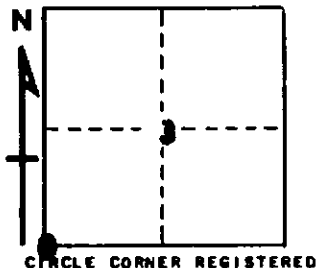

22" W. Pine N 20 W 12.9'

11" B. Cherry, Twin N 70 W 25.3'

AND Random West Due S 40.5'

Random North Due E 10.3'

DESCRIPTION IN DETAIL AS TO HOW CORNER WAS LOCATED AND IDENTIFIED OR RESTORED.

THIS CORNER WAS RECOVERED BY RETRACING SURVEY OF SEC. 3 BY H. C. SALISBURY. SEE REPORT OF SURVEY AND PLAT OF SURVEY, SEC. 3, T16N-R15W.

SURVEYOR'S SEAL

SIGNED

*Carl F. Boser*

REGISTERED LAND SURVEYOR 12028

DATE

5/27/69