

LAND CORNER RECORDATION CERTIFICATE

FILING REQUIREMENT OF ACT 74, MICH. P.A.1970

FOR CORNERS OF--:	LOCATED IN--:	CORNER CODE NUMBER
1. PUBLIC LAND SURVEY _____	T. <u>16</u> N. <u>●</u> , R. <u>16</u> W. <u>●</u>	E-1; E-2; E-3; G-2
2. PROPERTY CONTROLLING IN SECTION _____	T. _____ N. _____ S., R. _____ E. _____ W. _____	_____
3. MISCELLANEOUS PROPERTY IN SECTION _____	T. _____ N. _____ S., R. _____ E. _____ W. _____	_____
4. LOT NO. _____, RECORDED PLAT _____		
5. PRIVATE CLAIMS _____		

REGISTER OF DEEDS STAMP AND FILING NUMBER

I, Carl F. Roser, do hereby certify that under requirements of P.A. 74, Michigan P.A. of 1970, the corner points mentioned in lines 1 and 2 above were, in a field survey on October 18, 1976, established, re-established, monumented, re-monumented, recovered or restored as expressed below and in conformance with regulations and rules therefore as required in the current manual of survey instructions of the United States Department of the Interior, Bureau of Land Management or by a decree of a court of law. Furthermore, that the corner points mentioned in lines 3, 4 and 5 above were, in a field survey on _____, 19____, found, recovered, restored, established or re-established as expressed below and in conformance with the rules of the Michigan State Board of Registration for Land Surveyors or, by a Decree of a Court of law:

~~A - Description of original monument and accessories and or subsequent restoration~~

C. (continued)

G-2		
Found 1½"x1½" sq. head bolt (buried)		
11" R. Pine	S25°E	60.82
11" R. Pine	S50°W	62.60
10" Cherry	N70°W	96.65
Old field berm & fence remains (down)		
to North	Due E	60'±
Old Forest Service post w/rusty		
loc. tag	Due S	20.5


B. Description of corner evidence found and/or method applied in restoring or re-establishing corner: "

- 1 Found 1½" pipe in E-W fence remains for sec. corner common to Sec. 4 & 5, on north line of T16N-R16W; as previously found and accepted by RLS Clint Cole.
- 2 Reestablished ¼ corner on west line of Sec. 4; on line between found NW & SW corners of Sec. 4 and at prorated distance to U.S. government survey.
- 3 Found 1½" pipe at remains of old fence corner, E-W-S, fence being all down at fence corner. Corner previously found and accepted by RLS Clint Cole.
- 2 Found square head bolt in E-W county road (sand) as previously found and accepted by RLS Clint Cole.

C. Description of monument for corner and accessories established to perpetuate locating the position of the corner:

E-1	E-2	E-3
Fd. & accepted 1½" pipe, added cedar post w/loc. tag	Set DNR mon. & cedar post in N-S fence (crooked)	Fd. 1½" pipe
10" Ash N05°W 24.12	12" S.Maple N42°W 42.4	15" Ash N12°E 44.97
3" Ash S85°W 19.3	8" S.Maple N60°E 25.0	23" Oak N65°E 23.58
6" Maple N80°E 25.8	8" Hemlock S40°E 29.8	7" Oak S23°W 12.60
S'ly edge of river Due N 69'±	Fence W'ly Due S 119'±	Forest Service post w/rusty loc. tag Due E 9'

SIGNED BY Carl F. Roser DATE 10-31-77
 SURVEYOR'S MICHIGAN REGISTRATION NO. 12028

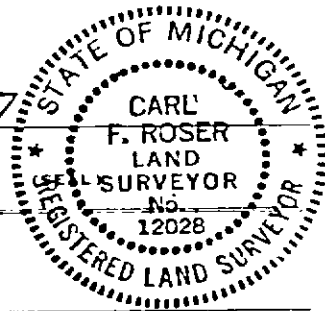

FOR STATE AND UNITED STATES AGENCIES:
 SIGNED BY _____ DATE _____
CHIEF OF SURVEY PARTY
 APPROVED AND SIGNED BY _____ DATE _____
MICHIGAN REGISTERED LAND SURVEYOR

CRYSTAL TOWNSHIP
OCEANA COUNTY

SURVEYOR'S MICHIGAN REGISTRATION NO. _____

MAY PLACE SKETCH ON BACK OR ATTACHED SHEET