

**SURVEY &
REMONUMENTATION**

APR 25 1995

COMMISSION

LAND CORNER RECORDATION CERTIFICATE

Filing Requirement of Act 74, Mich. P.A. 1970

STATE OF MICHIGAN
COUNTY OF OCEANA
RECEIVED FOR RECORD

100577

'95 JAN -4 P 3:24

For corners in

OCEANA

(County)

Located In:

Corner Code #

- | | | | | | |
|------------------------------------|---|-----|---|-----|------|
| 1. Public Land Survey | T | 16N | R | 15W | E-12 |
| | T | | R | | |
| | T | | R | | |
| | T | | R | | |
| 2. Property Controlling in Section | S | | T | R | |
| | S | | T | R | |
| 3. Miscellaneous Property in Sec. | S | | T | R | |
| | S | | T | R | |

Joseph E. Matthews
REGISTER OF DEEDS

Register of Deeds Stamp & File Number

4. Lot No. _____, Recorded Plat _____
5. Private Claims _____

A	B	C	D	E	F	G	H	I	J	K	L	M
2	6	5	4	3	2							
3												
4	7	8	9	10	11	12						
5												
6	18	17	16	15	14	13						
7												
8	19	20	21	22	23	24						
9												
10	30	29	28	27	26	25						
11												
12	31	32	33	34	35	36						
13												

I, J. Randolph Hepworth, in a field survey on September 1, 1994, do hereby certify that under requirements of P.A. 74, Michigan P.A. of 1970, the corner points mentioned in lines 1 and 2 above were in conformance with regulations and rules therefore as required in the current manual of survey instructions of the United States Department of the Interior, Bureau of Land Management or by a decree of a Court of Law and/or that the corner points mentioned in lines 3, 4 and 5 above were in conformance with the rules of the Michigan Board of Land Surveyors or by a Decree of a Court of Law; established, re-established, monumented, re-monumented, recovered, found as expressed below:

NOTE: Not more than 4 corners, all in the same town and range, may be recorded on this certificate.

A. Description of original monument and accessories and/or subsequent restoration:

E-12 1/4 CORNER COMMON TO SECTIONS 32 and 33 T16N,R15W COLFAX TWP

GLO SET POST 10" Pine S8°W 11.2' 8" Hemlock S21°E 15.8'

OCRC Witness Book; 5-14-51, Well Point on Fence line to East; No witnesses recited

No other historical records are known to me.

B. Description of corner evidence found and/or method applied in restoring or reestablishing corner

I found a R/R Spike at the surface of the road. Corner falls in the center of a north-south asphalt road and gravel road to west. A field drain runs to the East. Upon removal of the R/R Spike, I found it to be above a 1 1/2" Pipe 7" below the asphalt surface. I set a 1/2"x8" Iron inside the Pipe to raise it to the surface.

No evidence is known to me that would lead me to believe that the corner should be at another position. The 1/2" Iron above the 1 1/2" Pipe is ACCEPTED AS A CAREFUL AND FAITHFUL PERPETUATION OF THE POSITION OF THE ORIGINAL CORNER.

C. Description of monument for corner and accessories established to perpetuate locating the position of the corner.

E-12 1/4 CORNER COMMON TO SECTIONS 32 and 33 T16N,R15W COLFAX TWP


SET "COUNTY SURVEYOR" HARRISON 2 3/4"x20" CAST IRON MONUMENT on top of found 1 1/2" Pipe

60d spk SE Face	12" Elm	31°az	60.34	EDM
60d spk N Face	12" Willow	105°az	54.13	EDM
60d spk W Face	16" Willow	149°az	65.78	EDM
60d spk E Face	10" Maple	187°az	217.50	EDM
	set 1/2" Iron	west	82.61	EDM
	set 1/2" Iron	west	233.00	EDM

Oceana County Remonumentation
Peer Group Reviewed & Approved

Date: 8-18-94

JRH
J. Randolph Hepworth
Oceana County Surveyor

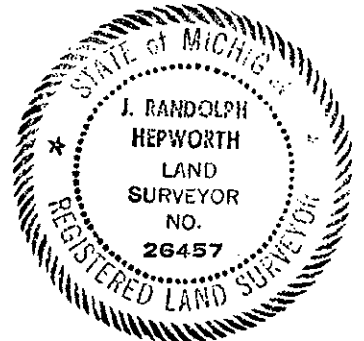

Signed by *J. Randolph Hepworth*

Date November 7, 1994

Surveyor's Michigan License No. 26457