

JAN 18 2001

SECTION

LAND CORNER RECORDATION CERTIFICATE
Filing Requirement of Act 74, Mich. P.A. 1970

STATE OF MICHIGAN
COUNTY OF OCEANA
RECEIVED FOR RECORD

21 DEC 2000 3:19:31 PM

For corners in


<u>Oceana</u> (County)	Located In:	Corner Code #
1. Public Land Survey	T <u>16</u> N R <u>15</u> W	C-6
	T ___ R ___	_____
	T ___ R ___	_____
	T ___ R ___	_____
2. Property Controlling in Section	S ___ T ___ R ___	_____
	S ___ T ___ R ___	_____
3. Miscellaneous Property in Sec.	S ___ T ___ R ___	_____
	S ___ T ___ R ___	_____

JOSEPH E. MERTEN
REGISTER OF DEEDS

101019

Register of Deeds Stamp & File Number

4. Lot No. _____, Recorded Plat _____
5. Private Claims _____

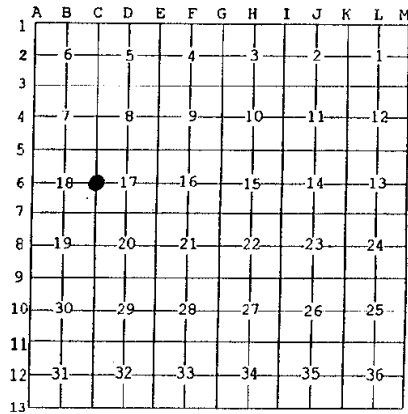

I, J. Randolph Hepworth, in a field survey on Aug 18, 2000, do hereby state that under requirements of P.A. 74, Michigan P.A. of 1970, the corner points mentioned in lines 1 and 2 above were in conformance with regulations and rules therefore as required in the current manual of survey instructions of the United States Department of the Interior, Bureau of Land Management or by a decree of a Court of Law and/or that the corner points mentioned in lines 3, 4 and 5 above were in conformance with the rules of the Michigan Board of Land Surveyors or by a Decree of a Court of Law; established, re-established, monumented, recovered, found as expressed below:

NOTE: Not more than 2 corners, all in the same town and range, may be recorded on this certificate.

A. Description of original monument and accessories and/or subsequent restoration:

C-6 1/4 CORNER COMMON TO SECTIONS 17 & 18 T16N, R15W COLFAX TOWNSHIP

GLO John Hodgson 1838 SET POST 16" Maple N36°E 11 lks 14" Maple S81°W 27lks

Book B, Pg. 36, F.F. Wetmore, 1902; Sec. 18-16-15 Breakdown "Iron Stake set by J. Bean 1883."

Book B, Pg. 38, F.F. Wetmore, 1902; Sec. 18-16-15 Breakdown "Iron Stake set by J. Bean 1883."

Book C, Pg. 106, HA Grant, 1905; Sec. 17-16-15 Breakdown "Iron Rod set by J. Bean 1883."

1) 32" Pine Stump N37.5°W 38.5 lks 2) 36" Pine Stump S33.5°W 35 lks

LCRC # 100416, JR Hepworth #26457, 3/8/90, Fd 1/2" IR (Field work - 7-22-82)

Ken N-S Road; Fence to E 3) 24" Oak S30°W 58.88'

4) 24" Maple E 40.16'

Oceana County Reaumentation
Peer Group Reviewed & Approved

Date: 11-9-00

J. Randolph Hepworth
Oceana County Surveyor

B. Description of corner evidence found and/or method applied in restoring or reestablishing corner.


I found a 1/2" x 42" smooth Iron in the centerline of N-S Road and on old occupation line to the east. In my opinion this iron is the J. Bean, Jr., 1883 corner as it is similar to the many others that I have found. Witness #1 & #2 are gone. Witness #3 and #4 are standing and measure OK.

I accept the 1/2" Iron as the best available evidence of the position of the original corner. No evidence is known to me that would lead me to believe the corner should be at another location.

C. Description of monument for corner and accessories established to perpetuate locating the position of the corner:

Set 4"x20" Harrison Cast Iron Monument, stamped "County Surveyor" and "26457" above the 1/2" Iron which was driven down

3) Ex. 60d spk	NW Face	32" Oak	204°az	58.26'	EDM
4) Ex. 60d spk	N Face	18" tr. Maple	97°az	40.55'	EDM
Ex. 60d spk	S Face	8" W Oak	265°az	31.00'	EDM
Set 60d spk	NW Face	12" R Pine	50°az	50.59'	EDM

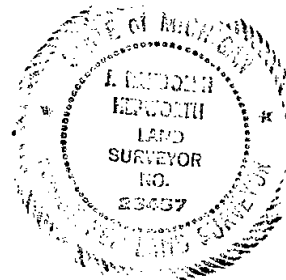

Signed by J. Randolph Hepworth
Surveyor's Michigan License No. 26457

Date December 15, 2000