MICHIGAN
DEPARTMENT of CONSERVATION
Field Administration Division

District ..... **County** OCEANA ..... **T.** 16 **N.**, **R.** 17 **W.**

Notes

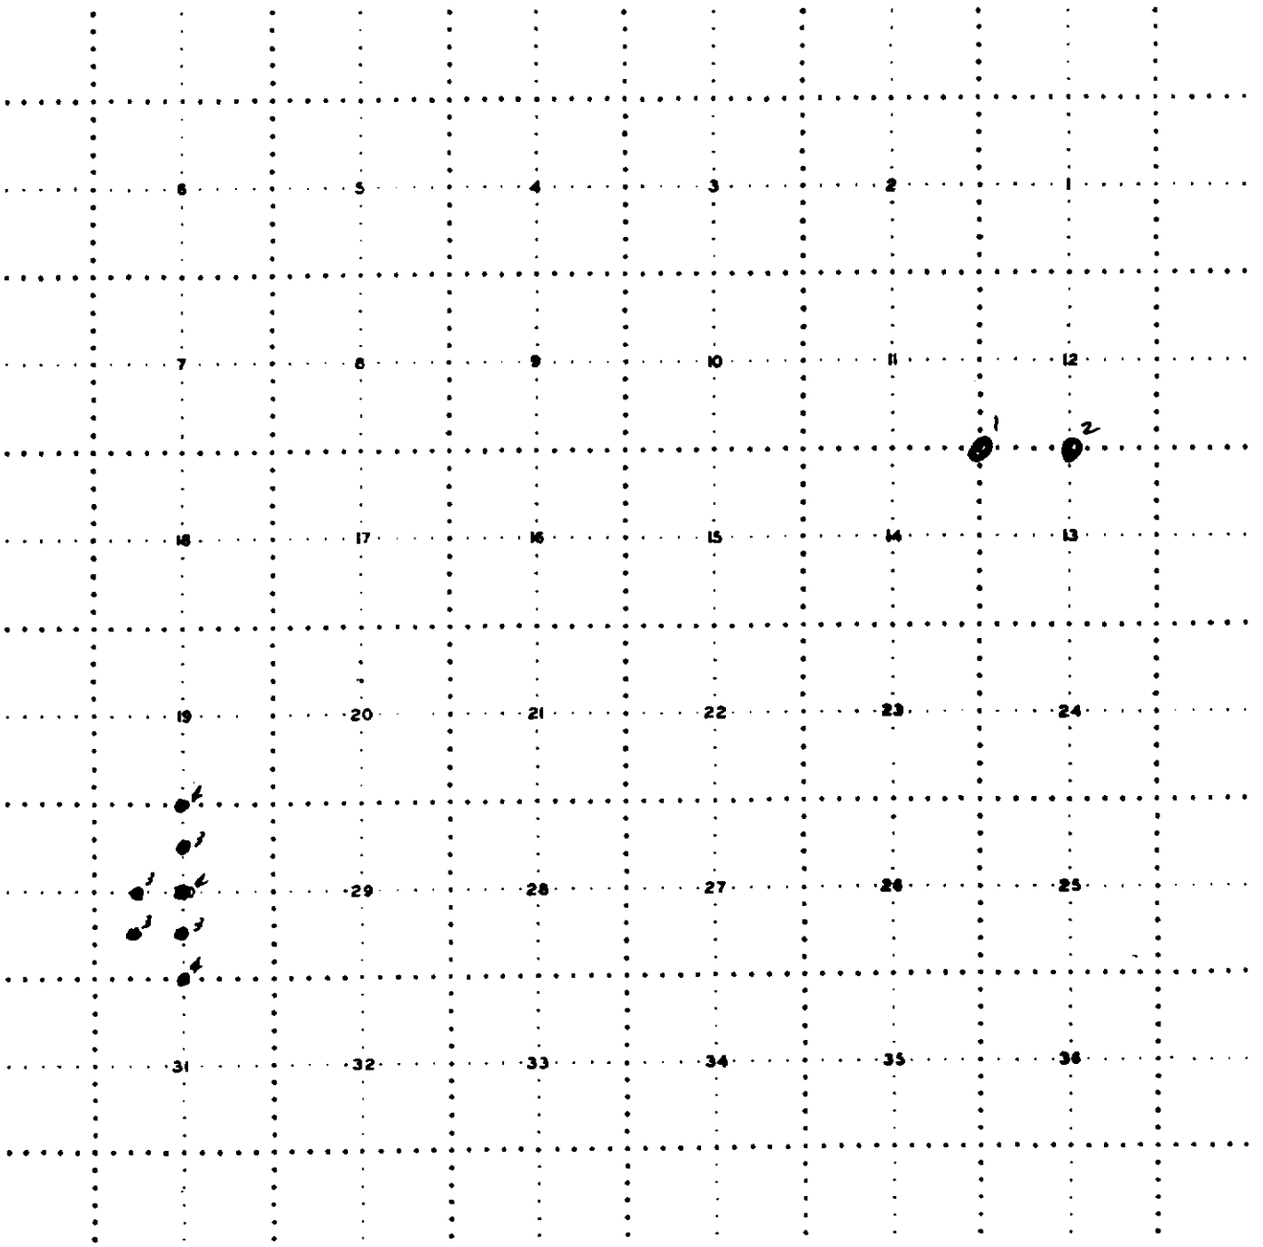

Mapped by:

Date:

Con Records - Reg II
copied 2-15-89