

Survey Proj #76-13

MAP SHEET

TOWN 15N RANGE 18W

Oceana Co.  
COUNTY


Golden Twp.  
TOWNSHIP

NUMBER OF ACRES

DATE	FILE NO.
DIVISION	DISTRICT
MAPPED BY:	
PHOTO NUMBERS	

E OF LAND

P SE OF MAP

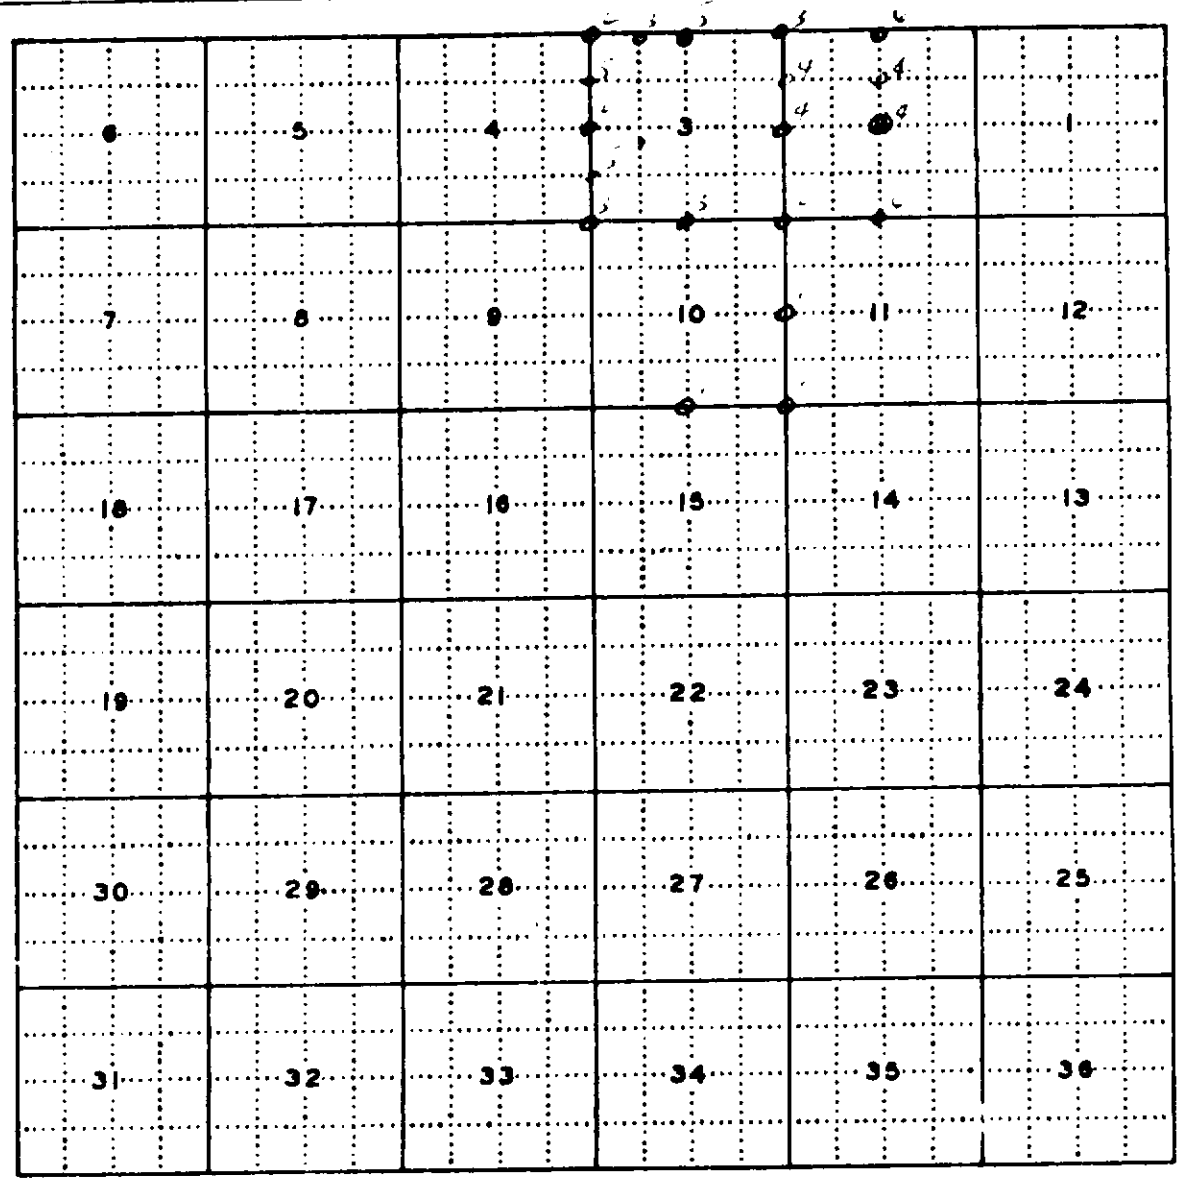

REMARKS