

LAND CORNER RECORDATION CERTIFICATE

FILING REQUIREMENT OF ACT 74, MICH. P.A.1970

FOR CORNERS OF--:	LOCATED IN--:	CORNER CODE NUMBER
1. PUBLIC LAND SURVEY	T. _____ N. _____ E. _____ S. _____ R. _____ W. _____	_____
2. PROPERTY CONTROLLING IN SECTION 30	T. 16 N. 17 S. _____ R. _____ W. _____	5; 8; 11; 12
3. MISCELLANEOUS PROPERTY IN SECTION	T. _____ N. _____ E. _____ S. _____ R. _____ W. _____	_____
4. LOT NO. _____, RECORDED PLAT _____		
5. PRIVATE CLAIMS _____		

REGISTER OF DEEDS STAMP AND
FILING NUMBER

I, Carl F. Roser, do hereby certify that under requirements of P.A. 74, Michigan P.A. of 1970, the corner points mentioned in lines 1 and 2 above were, in a field survey on December 6, 1979, established, re-established, monumented, re-monumented, recovered or restored as expressed below and in conformance with regulations and rules therefore as required in the current manual of survey instructions of the United States Department of the Interior, Bureau of Land Management or by a decree of a court of law. Furthermore, that the corner points mentioned in lines 3, 4 and 5 above were, in a field survey on _____, 19____, found, recovered, restored, established or re-established as expressed below and in conformance with the rules of the Michigan State Board of Registration for Land Surveyors or, by a Decree of a Court of law:

~~A. Description of original monument and recovery and for subsequent restoration:~~

C. (continued)

12
Set 5/8"x40" rerod w/RLS cap
& cedar post w/loc. tag
4" W. Pine S80°E 19.03
18" B. Cherry S25°E 18.85
Old fence corner position, fence
remains N, E & W is Due W
23'±

B. Description of corner evidence found and/or method applied in restoring or re-establishing corner:


- 5 Found and accepted N & D concrete monument for 1/8 corner.
- 8 Established W 1/8 on E-W 1/4 line, Sec. 30 on line between the center & W 1/4 of Sec. 30 & at prorated distance to G.L.O. plat (run-out section).
- 11 Established center of SW 1/4 of Sec. 30 per standard B.L.M. instructions.
- 12 Established S 1/8 on N-S 1/4 line, Sec. 30; equidistant & on line between fd. center of Sec. and fd. S 1/4 corner. Corner is in line with old fence remains S, E & W.

C. Description of monument for corner and accessories established to perpetuate locating the position of the corner:

5	8	11
Fd. 4" round conc. mon w/1/2" rerod; buried on E'ly edge of dirt road	Set 5/8"x34" rerod w/RLS cap & cedar post w/loc. tag	Set 5/8"x34" rerod w/RLS cap & cedar post w/loc. tag
36" W. Oak S40°W 29.64	3" B. Oak N25°E 21.98	9" R. Oak N35°E 23.40
40" R. Oak N60°W 42.59	2" R. Pine N45°W 15.31	4" R. Oak S50°E 12.06
Set cedar post w/loc. tag Due E 16.5		Ctr. N-S trail Due W 13'

SIGNED BY Carl F. Roser 5-14-80 DATE _____

SURVEYOR'S MICHIGAN REGISTRATION NO. 12028

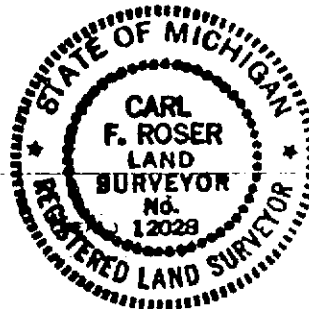

FOR STATE AND UNITED STATES AGENCIES:

SIGNED BY _____ DATE _____

CHIEF OF SURVEY PARTY

APPROVED AND SIGNED BY _____ DATE _____

MICHIGAN REGISTERED LAND SURVEYOR

(SEAL)

SURVEYOR'S MICHIGAN REGISTRATION NO. _____

WEARE TOWNSHIP
OCEANA COUNTY