


STATE OF MICHIGAN
DEPARTMENT
OF
NATURAL RESOURCES

LAND CORNER RECORD

OCEANA COUNTY
T 16 N R 17 W

DESCRIPTION OF CORNER N 1/4 Corner Section 13
CORNER MONUMENT Set D.N.R. Mon. & Sq. Cedar Post by Fd. 1/2" Iron Rod
DATE MONUMENT PLACED AND WITNESSED 1-18-72
WITNESSES TO CORNER..... Beech 18" N 25 W 66.0'

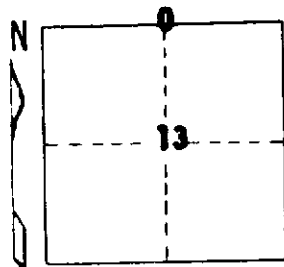


W. Oak 6" N 60 W 50.4'
W. Oak 7" N 65 E 5.9'
AND Remains of fence Corner N'y & E'y Due N 30.5'
Crooked E-W Trail Rd. Due S 73'

CIRCLE CORNER REGISTERED

DESCRIPTION IN DETAIL AS TO HOW CORNER WAS LOCATED AND IDENTIFIED OR RESTORED.

Recovered 1/2" Iron rod, flush with ground, 30.5' South of old fence corner.

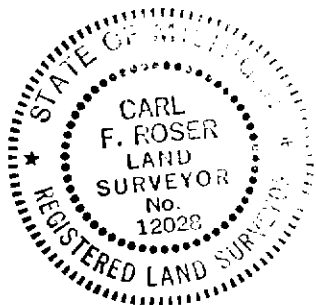

SURVEYOR'S SEAL

SIGNED

Carl F. Roser

DATE

1-25-72

DISTRIBUTION:

REGISTERED LAND SURVEYOR **12028**

County Courthouse
Area Forester (Regions I & II)
District or Region Surveyor
Forestry Div., Lansing

R 4047
Rev. 10/68