


STATE OF MICHIGAN
DEPARTMENT
OF
NATURAL RESOURCES

LAND CORNER RECORD

OCEANB COUNTY
T 16 N R 17 W

DESCRIPTION OF CORNER NW CORNER SECTION 13
CORNER MONUMENT Set U.N.R. Mon. 8" deep in sand road intersection
DATE MONUMENT PLACED AND WITNESSED 1-18-72
WITNESSES TO CORNER.....

<u>W. Oak 8"</u>	<u>N 70 E</u>	<u>33.7'</u>
<u>Beech 16"</u>	<u>S 70 E</u>	<u>33.6'</u>
<u>Tw. White Oak 18"</u>	<u>S 20 W</u>	<u>47.3'</u>
<u>AND B. Oak 16"</u>	<u>N 40 W</u>	<u>120.8'</u>
<u>Set Sq. Cedar Post w/loc tag</u>	<u>Due E</u>	<u>33'</u>

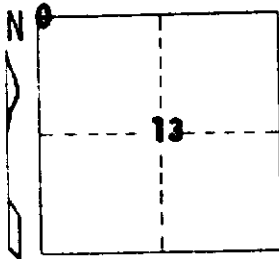


CIRCLE CORNER REGISTERED

DESCRIPTION IN DETAIL AS TO HOW CORNER WAS LOCATED AND IDENTIFIED OR RESTORED.

Corner reestablished in line with old fence remains South and Road North, and in line with random line from West, which is 30' N of and parallel to old Southerly R.O.W. fence.

A corner at this position is very close to being twice the distance and on a line across the North 1/4 corner and the NE Corner of Section 13.

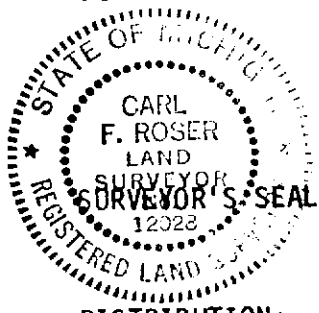

SIGNED

Carl F. Roser
REGISTERED LAND SURVEYOR

DATE

1-25-72

12028

DISTRIBUTION:

County Courthouse
Area Forester (Regions I & II)
District or Region Surveyor
Forestry Div., Lansing

R 4047
Rev. 10/68