

SURVEY & REMONUMENTATION

OCT 27 1993

COMMISSION

**OCEANA COUNTY REMONUMENTATION
LAND CORNER RECORDATION CERTIFICATE
Filing Requirement of Act 74, Mich. P.A. 1970**

STATE OF MICHIGAN
COUNTY OF OCEANA
RECEIVED FOR RECORD
100492
93 OCT -7 P2:44

For corners in

<u>OCEANA</u> (County)	Located In:	Corner Code #
1. Public Land Survey	T16N R 18W	K-6
	T ___ R ___	___
	T ___ R ___	___
	T ___ R ___	___
2. Property Controlling in Section	S ___ T ___ R ___	___
	S ___ T ___ R ___	___
3. Miscellaneous Property in Sec.	S ___ T ___ R ___	___
	S ___ T ___ R ___	___

J. E. Meekins
REGISTER OF DEEDS

Register of Deeds Stamp & File Number

4. Lot No. _____, Recorded Plat _____
5. Private Claims _____

	A	B	C	D	E	F	G	H	I	J	K	L	M
2	6	5	4	3	2	1							
3													
4	7	8	9	10	11	12							
5													
6	18	17	16	15	14	13							
7													
8	19	20	21	22	23	24							
9													
10	30	29	28	27	26	25							
11													
12	31	32	33	34	35	36							
13													

I, J. Randolph Hepworth, in a field survey on September 28, 1993, do hereby certify that under requirements of P.A. 74, Michigan P.A. of 1970, the corner points mentioned in lines 1 and 2 above were in conformance with regulations and rules therefore as required in the current manual of survey instructions of the United States Department of the Interior, Bureau of Land Management or by a decree of a Court of Law and/or that the corner points mentioned in lines 3, 4 and 5 above were in conformance with the rules of the Michigan Board of Land Surveyors or by a Decree of a Court of Law; established, re-established, monumented, re-monumented, recovered, found as expressed below:

NOTE: Not more than 4 corners, all in the same town and range, may be recorded on this certificate.

A. Description of original monument and accessories and/or subsequent restoration:

K-6 1/4 CORNER COMMON TO SEC 13 & 14 PENTWATER TWP T16N, R18W
 GLO SET POST 10" CEDAR S10°E 7.3' 4" ALDER N47°W 4.0'
 BOOK A - 370 HA GRANT, JUNE 1894 IRON GRATE BAR 16" LONG NO WITNESSES RECITED
 OCRC WITNESS: IRON 11-13-62 SPIKE IN BOX ELDER S30°W 44.6
 SPIKE IN POWER POLE N08°E 26.55 GUY WIRE N45°E 39.80
 LCRC # 100443 R. HEPWORTH, LS 26457 1-7-91 FOUND 3/4" PIPE 4' N OF E-W PAVEMENT at surface
 TOP FIRE HYDRANT 298°AZ 47.68 N. COR. CONC PROJ. MARKER 170°AZ 31.92
 POWER POLE 24°AZ 26.28 CONC. MONUMENT SOUTH 33.0'


B. Description of corner evidence found and/or method applied in restoring or reestablishing corner

FOUND 3/4" PIPE AS PER LCRC #100443 AND IS ACCEPTED AS A CAREFUL AND FAITHFUL PERPETUATION OF THE POSITION OF THE ORIGINAL CORNER. Found 3/4" pipe was found over a 1/2" pipe which was inside a 1"x3" pipe at original pavement- 1.5' below surface.

C. Description of monument for corner and accessories established to perpetuate locating the position of the corner.

K-6 1/4 CORNER COMMON TO SEC 13 & 14 PENTWATER TWP T16N, R18W
 SET "COUNTY SURVEYOR" HARRISON 4"x20" CAST IRON MONUMENT IN PLACE OF FOUND 3/4" PIPE

C/L OF E-W PAVEMENT	SOUTH	4 feet
TOP FIRE HYDRANT	N62°W	47.68 TAPE
N. COR. CONC PROJ. MARKER	S10°E	31.92 TAPE
60d SPK E FACE POWER POLE	N24°E	26.28 TAPE
CONC. MONUMENT	SOUTH	33.0' TAPE

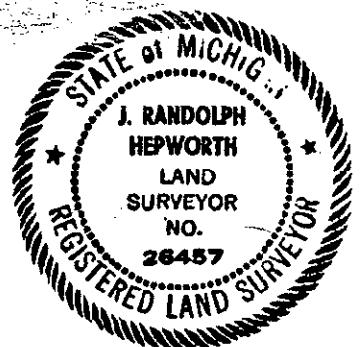

Signed by J. Randolph Hepworth
 Surveyor's Michigan License No. 26457

Date October 6, 1993

11-5-93