

MAY 16 1997

STATE OF MICHIGAN
COUNTY OF OCEANA
RECEIVED FOR RECORD

100730

LAND CORNER RECORDATION CERTIFICATE

Filing Requirement of Act 74, Mich. P.A. 1970

'96 DEC 19 AM 1:14

For corners in

Oceana

(County)

Located In:

Corner Code #

- 1. Public Land Survey T 16N R 16W H-7
- T _____ R _____
- T _____ R _____
- T _____ R _____
- 2. Property Controlling S _____ T _____ R _____
- In Section S _____ T _____ R _____
- 3. Miscellaneous S _____ T _____ R _____
- Property in Section S _____ T _____ R _____

J. Randolph Hepworth
REGISTER OF DEEDS

Register of Deeds Stamp & File Number

- 4. Lot No. _____, Recorded Plat _____
- 5. Private Claims _____

A	B	C	D	E	F	G	H	I	J	K	L	M
2	6	5	4	3	2							
3												
4	7	8	9	10	11	12						
5												
6	18	17	16	15	14	13						
7												
8	19	20	21	22	23	24						
9												
10	30	29	28	27	26	25						
11												
12	31	32	33	34	35	36						
13												

I, J. Randolph Hepworth, in a field survey on October 11, 1996, do hereby certify that under requirements of P.A. 74, Michigan P.A. of 1970, the corner points mentioned in lines 1 and 2 above were in conformance with regulations and rules therefore as required in the current manual of survey instructions of the United States Department of the Interior, Bureau of Land Management or by a decree of a Court of Law and/or that the corner points mentioned in lines 3, 4 and 5 above were in conformance with the rules of the Michigan Board of Professional Surveyors or by a Decree of a Court of Law; established, re-established, monumented, re-monumented, recovered, found as expressed below:

NOTE: Not more than 4 corners, all in the same town and range, may be recorded on this certificate.

A. Description of original monument and accessories and/or subsequent restoration:

H-7 1/4 Corner Common to Sections 15 & 22 T16N, R16W Crystal Township

GLO USED 8" Beech as POST No Witnesses
Book A, Pg 268; H. Grant, 1887; "Found Gov't stake & set wagon skein in same place."
Book A, Pg 244; E. Hyde, 1889; "Found an iron wagon thimble set by H. Grant, Dept Co Surveyor."
Unrecorded Survey J. Randolph Hepworth #26457 7/27/83 Fd 1" pipe

B. Description of corner evidence found and/or method applied in restoring or reestablishing corner.

I found in the centerline of an east-west asphalt road and in the centerline of gravel road to the north and on an old fence line to the south 8" below the surface an old wagon skein with a JRH 60d spk inside. Corner is as described by Grant, 1887, and by Hyde, 1889.

This Iron was accepted as the best evidence of the corner and was accepted as being a careful and faithful perpetuation of the original corner. No evidence is known to me that would lead me to believe that the corner should be in another location.

I set a 5/8"x36" Iron with a 2" aluminum cap stamped "Oceana County Remonumentation" and "26457" inside the wagon skein.

C. Description of monument for corner and accessories established to perpetuate locating the position of the corner.

H-7 1/4 Corner Common to Sections 15 & 22 T16N, R16W Crystal Township


5/8"x36" Iron with a 2" aluminum cap stamped "Oceana County Remonumentation" and "26457"

60d spk	W Face	30" Maple	185°az	26.45	EDM
60d spk	NW Face	18" W Pine	234°az	82.18	EDM
60d spk	S Face	8" Maple	80°az	163.91	EDM
60d spk	NW Face	Power Pole	34°az	208.54	EDM
60d spk	E Face	Power Pole	349°az	170.16	EDM
	center of Road Name Sign Post		323°az	55.43	EDM

Oceana County Remonumentation
Peer Group Reviewed & Approved

Date: 11-17-96

J. Randolph Hepworth
J. Randolph Hepworth
Oceana County Surveyor

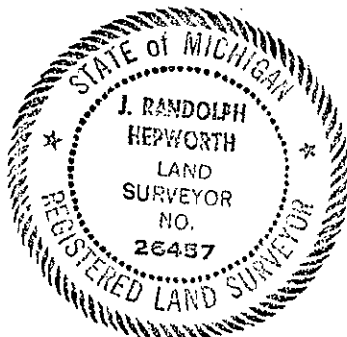

Signed by *J. Randolph Hepworth*

Date December 5, 1996

Surveyor's Michigan License No. 26457