

LAND CORNER RECORDATION CERTIFICATE
Filing Requirement of Act 74, Mich. P.A. 1970

corners in Ogemaw <small>County</small>	Located In:	Corner Code #
Public Land Survey	T 21N R 1E	M-8
	T _____ R _____	_____
	T _____ R _____	_____
	T _____ R _____	_____
Property Controlling in Section	S _____ T _____ R _____	_____
Miscellaneous	S _____ T _____ R _____	_____
Property in Sec.	S _____ T _____ R _____	_____

RECORDED
OGEMAW COUNTY, MI
RECEIVED DEC 21, 1990 AT 12:25 P.M.
LIBER 2 of Cor. PAGE 110
Surveys
William Miller
REGISTER OF DEEDS
OGEMAW COUNTY
Register of Deeds Stamp & File Number

Lot No. _____ Recorded Plat _____
Private Claims _____

	A	B	C	D	E	F	G	H	I	J	K	L	M
13													

Marvin E. Myers in a field survey on November 26, 1990
I hereby certify that under requirements of P.A. 74, Michigan P.A. of 1970, the corner points mentioned in lines 1 and 2 above were in conformance with regulations and rules therefore as required in the current manual of survey instructions of the United States Department of the Interior, Bureau of Land Management or by a decree of a Court of Law and/or that the corner points mentioned in lines 3, 4 and 5 above were in conformance with the rules of the Michigan Board of Land Surveyors or by a Decree of a Court of Law; established, re-established, monumented, re-monumented, recovered, found as expressed below:


NOTE: Not more than 4 corners, all in the same town and range, may be recorded on this certificate.

Description of original monument and accessories and/or subsequent restoration:
GLO James Richardson - 1961
Mon.-Post Mon.-Unknown
Wit: 14" B. Ash S31°W 12 Lks.
12" Elm N78°N 19 Lks.

Description of corner evidence found and/or method applied in restoring or reestablishing corner:
M-8 Found 3/4" pipe verified position by measurement to nearby plat monuments. Plats by James Richardson. Replaced 3/4"x18" pipe with 1/2"x18" steel bar. Corner is on line with fence lines East and West.

Description of monument for corner and accessories established to perpetuate locating the position of the corner:
M-8 Monument 1/2"x18" steel bar and plastic cap marked "MEM 31600"
Wit: Concrete plat monument N88°52'W 33.02'
Concrete plat monument N27°W 74.88'
Stop Sign post N50°W 35.50'

Signed by *Marvin E. Myers*
Surveyor's Michigan License No. 31600

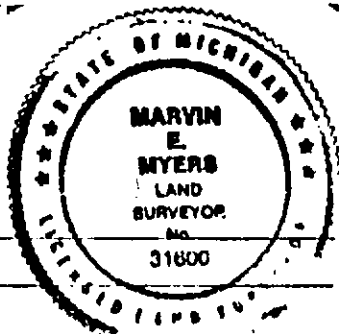

Date Nov 30, 1990