

APR 08 1999

Ogemaw County Remonumentation
LAND CORNER RECORDATION CERTIFICATE
Filing Requirement of Act 74, Mich. P.A. 1970

SECTION

For corners in

Ogemaw (County) Located in: Corner Code #
1. Public Land Survey T21N R01E A-4
2. Property Controlling in Section S T R
3. Miscellaneous Property in Sec. S T R

LIBER 3 PAGE 195

STATE OF MICHIGAN OGEAW COUNTY RECORDED

23 DEC 1998 3:44:41 P

WANDA MUZIK REGISTER OF DEEDS

Register of Deeds Stamp & File Number

4. Lot No. , Recorded Plat
5. Private Claims

I, Timothy L Lapham, in a field survey on September, 19 98, do hereby state that under requirements of P.A. 74, Michigan P.A. of 1970, the corner points mention in lines 1 and 2 above were in conformance with regulations and rules therefore as required in the current manual of survey instructions of the United States Department of the Interior, Bureau of Land Management or by a decree of a Court of Law and/or that the corner points mentioned in lines 3, 4 and 5 above were in conformance with the rules of the Michigan Board of Land Surveyors or by a Decree of a Court of Law; established, re-established, monumented, recovered, found as expressed below:

Grid table with columns A-L and rows 1-13. Row 1: A-L. Row 2: 6-1. Row 3: 7-12. Row 4: 18-13. Row 5: 19-24. Row 6: 30-25. Row 7: 31-36.

NOTE: Not more than 2 corners, all in the same town and range, may be recorded on this certificate

A. Description of original monument and accessories and/or subsequent restoration:

A-4: GLO 2/13/1837 J. Brink set post
Hemlock 10 S19W 21
Hemlock 8 N64-1/2W 15

Roscommon Co LCRC 2-11
date and surveyor unknown
1/2" bar
S50W 26.5' 10" Twin R. Oak (1)
N51W 33.3' 8" R. Maple (2)
S71E 34.0' 8" R. Maple

Survey 11/06/1961 G. Henning
Set 1/2" iron bar and post
Same Accessories as Rosc. LCRC 2-11
distance to A-3 = 2621.8
distance to A-5 = 2621.8

Approved by Peer Review

12/15/98 DATE INITIALS


B. Description of corner evidence found and/or method applied in restoring or reestablishing corner:

A-4: Found 1/2"x24" rerod 9' west of the centerline of a trail. Found: living tree (1) and stump (2). Distances to A-3 and A-5 approximately match Henning Survey. Accepted found Iron as best evidence of correct corner position.

C. Description of monument for corner and accessories established to perpetuate locating the position of the corner:

A-4: Set 5/8"x36" rerod with aluminum Ogemaw County remon cap.

Witnesses:
S41E 24.31' NAIL IN 18" OAK
S70E 34.86' NAIL IN 10" MAPLE
N58W 28.82' NAIL IN 4" OAK
S50W 27.84' NAIL IN TWIN 18" OAK
SOUTH 1'+/- carsonite post

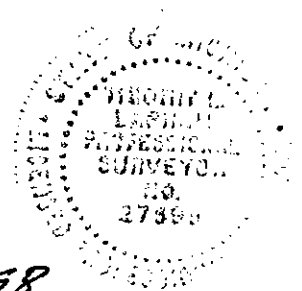

Signed by [Signature]
Surveyor's Michigan License No. 27595

Date 12/21/98