

APR 08 1999

Ogemaw County Remonumentation

LAND CORNER RECORDATION CERTIFICATE
Filing Requirement of Act 74, Mich. P.A. 1970

SECTION

For corners in

Ogemaw (County) Located in: Corner Code #
1. Public Land Survey T21N R01E A-5
2. Property Controlling in Section S T R
3. Miscellaneous Property in Sec. S T R

LIBER 3 PAGE 194
STATE OF MICHIGAN
OGEMAW COUNTY
RECORDED
23 DEC 1998 3:44:28 PM
WANDA MUZIK
REGISTER OF DEEDS
Register of Deeds Stamp & File Number

4. Lot No. , Recorded Plat
5. Private Claims

I, Timothy L Lapham, in a field survey on September, 19 98, do hereby state that under requirements of P.A. 74, Michigan P.A. of 1970, the corner points mention in lines 1 and 2 above were in conformance with regulations and rules therefore as required in the current manual of survey instructions of the United States Department of the Interior, Bureau of Land Management or by a decree of a Court of Law and/or that the corner points mentioned in lines 3, 4 and 5 above were in conformance with the rules of the Michigan Board of Land Surveyors or by a Decree of a Court of Law; established, re-established, monumented, recovered, found as expressed below:

Grid table with columns A-L and rows 1-13. Contains numbers 6-12, 18-24, 30-36.

NOTE: Not more than 2 corners, all in the same town and range, may be recorded on this certificate

A. Description of original monument and accessories and/or subsequent restoration:

A-5: GLO 2/13/1837 J Brink set post Roscommon Co. LCRC 2-11 date and surveyor unknown NNW 15.21' spike in 6" Twin Maple (5) Beech 12 S15-1/2W 19 Found post and 2" pipe West 23.13' spike in 6" Poplar (6) Beech 11 N61W 13 20" W Pine stump S37E 35.8' (1) ENE 13.33' spike in 5" Maple (7) Fence Corner N&E GLO 5/27/1846 B F Hall found post N27W 15.1' 5" R Maple (2) S70W 44.8' 5" R Maple (3) Beech 10 N17E 11 N52E 29.8' 4" R Maple (4) GLO 8/27/1850 G H Cannon found post Survey 10/1961 G Henning Found old post set 2" pipe Accessories same as Roscommon LCRC 2-11 Ogemaw Co. LCRC 3-106 12/12/1989 D Ledy 2" pipe - same accessories as Ledy section break DNR circa 1920 M Schaaf Survey 11/6/1961 G Henning Found old post and 2" pipe Accessories same as Roscommon LCRC 2-11 Sec. Break 1989-90 D Ledy -2" pipe


B. Description of corner evidence found and/or method applied in restoring or reestablishing corner:

A-5: Found 2" pipe 1' above grade at fences north and east. Drove pipe flush with ground. Found Witnesses: (1) stump very poor condition ;(2) and (5) are common witnesses to a living tree; (3), (4), (6) and (7) found living trees. Accepted found pipe as best evidence of correct corner position.

C. Description of monument for corner and accessories established to perpetuate locating the position of the corner:

A-5: Set 5/8"x36" rerod with aluminum Ogemaw County remon cap inside found pipe. Witnesses: N23W 15.22' NAIL IN 8" TWIN MAPLE (OBT) WEST 23.19' NAIL IN 6" POPLAR (OBT) S69W 45.12' NAIL IN 12" MAPLE (OBT) N79E 13.31' NAIL IN 8" MAPLE (OBT) N59E 29.70' NAIL IN 8" MAPLE (OBT) South 1'+/- carsonite post

Approved by Peer Review
12/15/98 DATE INITIALS

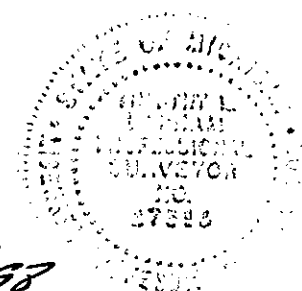

Signed by [Signature]
Surveyor's Michigan License No. 27595

Date 12/21/98