

APR 08 1999

Ogemaw County Remonumentation

LAND CORNER RECORDATION CERTIFICATE
Filing Requirement of Act 74, Mich. P.A. 1970

SECTION

For corners in

_____ Ogemaw _____ (County)	Located in:	Corner Code #
1. Public Land Survey	T21N R01E	A-9
	T _____ R _____	_____
	T _____ R _____	_____
	T _____ R _____	_____
2. Property Controlling in Section	S _____ T _____ R _____	_____
	S _____ T _____ R _____	_____
3. Miscellaneous Property in Sec.	S _____ T _____ R _____	_____
	S _____ T _____ R _____	_____

LIBER 3 PAGE 190

STATE OF MICHIGAN
OGEMAW COUNTY
RECORDED

23 DEC 1998 3:43:21 PM

WANDA HUZIK
REGISTER OF DEEDS

Register of Deeds Stamp & File Number

4. Lot No. _____, Recorded Plat _____
5. Private Claims _____

I, Timothy L Lapham, in a field survey on September, 1998, do hereby state that under requirements of P.A. 74, Michigan P.A. of 1970, the corner points mention in lines 1 and 2 above were in conformance with regulations and rules therefore as required in the current manual of survey instructions of the United States Department of the Interior, Bureau of Land Management or by a decree of a Court of Law and/or that the corner points mentioned in lines 3, 4 and 5 above were in conformance with the rules of the Michigan Board of Land Surveyors or by a Decree of a Court of Law; established, re-established, monumented, recovered, found as expressed below:

NOTE: Not more than 2 corners, all in the same town and range, may be recorded on this certificate

	A	B	C	D	E	F	G	H	I	J	K	L
1												
2	6		5		4		3		2		1	
3												
4	7		8		9		10		11		12	
5												
6	18		17		16		15		14		13	
7												
8	19		20		21		22		23		24	
9												
10	30		29		28		27		26		25	
11												
12	31		32		33		34		35		36	
13												

A. Description of original monument and accessories and/or subsequent restoration:

A-9: GLO 2/12/1837 J Brink set post W Pine 18 S64W 51 Hemlock 12 N45W 75	S42E 37.8' 8" Birch (1) S88E 53.5' 6" G Ash (2) N07E 41.5' 12" Tw R Oak (3)
GLO 5/26/1846 B F Hall found post Hemlock 14 N70E 28 Beech 4 S21E 40	Survey 3/11/1976 N Caldwell Accessories same as Ogemaw LCRC 1-152
GLO 8/24/1850 G H Cannon found post No additional accessories	Sec. Break not dated from Wade Trim no corner description or accessories
Ogemaw Co. LCRC 1-152 3/12/1976 N Caldwell Found "T" shaped steel fence post in edge of pipeline with 4x4 post S70E 44.2' P Stump scribed BT	Sec. Break 4/12/1995 D Ledy Accessories same as Ogemaw LCRC 1-152

B. Description of corner evidence found and/or method applied in restoring or reestablishing corner:

A-9: Found 1/2"x18" rerod with cap No. 12018 and 'T' post immediately next to it. Found witnesses (1), (2) and (3). Found 3/8" rerod 1.65' NE of found 1/2" rerod. Accepted found 1/2" rerod as best evidence of correct position of corner.


C. Description of monument for corner and accessories established to perpetuate locating the position of the corner:

A-9: Left 'T' post in place and set 5/8"x36" rerod with aluminum Ogemaw County remon cap.

Witnesses:
NORTHEAST 1.65' FOUND 3/8" REROD
N10E 42.25' NAIL IN 24" TWIN OAK (OBT)
EAST 53.84' NAIL IN 12 ASH OF TRIPLE (OBT)
S35E 38.29' NAIL IN 12" BIRCH (OBT)
S33W 39.52' NAIL IN 10" ASH
East 2'+/- carsonite post

Approved by Peer Review

12/15/98 DATE INITIALS

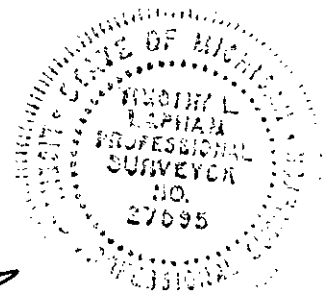

Signed by *[Signature]*
Surveyor's Michigan License No. 27595

Date 12/21/98