

APR 08 1999

Ogemaw County Remonumentation

SECTION

LAND CORNER RECORDATION CERTIFICATE
Filing Requirement of Act 74, Mich. P.A. 1970

For corners in

Ogemaw (County) Located in: Corner Code #
1. Public Land Survey T21N R01E G-1
2. Property Controlling in Section S T R
3. Miscellaneous Property in Sec. S T R

LIBER 3 PAGE 205
STATE OF MICHIGAN
OGEMAW COUNTY
RECORDED

23 DEC 1998 3:47:03 PM

WANDA MUZIK
REGISTER OF DEEDS

Register of Deeds Stamp & File Number

4. Lot No. Recorded Plat
5. Private Claims

I, Timothy L Lapham, in a field survey on December, 19 98 do hereby state that under requirements of P.A. 74, Michigan P.A. of 1970, the corner points mention in lines 1 and 2 above were in conformance with regulations and rules therefore as required in the current manual of survey instructions of the United States Department of the Interior, Bureau of Land Management or by a decree of a Court of Law and/or that the corner points mentioned in lines 3, 4 and 5 above were in conformance with the rules of the Michigan Board of Land Surveyors or by a Decree of a Court of Law; established, re-established, monumented, recovered, found as expressed below:

NOTE: Not more than 2 corners, all in the same town and range, may be recorded on this certificate

Grid table with columns A-L and rows 1-13. A dot is marked at the intersection of column G and row 1.

A. Description of original monument and accessories and/or subsequent restoration:

- G-1: GLO 5/24/1846 B.F. Hall set post 3 lk. west of standard post Beech 10" S13W 03 lk Beech 10" S50E 21 lk
LCRC 1-77 8/1976 R. Higgins set 1/2" bar and cap East 1.98 3/8" bar (1) West 22.0 fence corner (2) S45E fence corner (3)
survey unrecorded 7/30/1985 T. Lapham found capped iron East 1.98 3/8" bar (4) West 22.0 Fence corner (5) S45E 46.0 fence corner (6)

Section break 11/18/1994 T. Lapham corner material not specified no witnesses distance to G-2= 2526.66 (7)
County road plans 1997 J.P. May found CI #12180 NW corner of attached garage N48E 121.39 (8) 36" Sugar Maple S60E 72.87 12" Ash S68W 60.22 (9) U.P. N26W 52.54 (10) SE corner section 34 East 1.98 (11)

B. Description of corner evidence found and/or method applied in restoring or reestablishing corner:


G-1: No evidence of GLO corner. Road had been newly reconstructed and paved. First reset G-13 T22N R1E from witnesses then reset point from 1997 witnesses using (10) and (11). Witness (1) (4) and (10) are the same and were reset from other witnesses. Witness (2) and (5) are the same and is destroyed. Witnesses (3) and (6) appear to be the same and is destroyed. Distance (7) is approximately as measured. Found witness (8), measured 121.28 to corner of foundation, note: if measured to siding it would be approximately record distance. Found witness (9), measured 60.34. Accepted reestablished point as best evidence of correct corner position.

C. Description of monument for corner and accessories established to perpetuate locating the position of the corner:

G-1: Set 5/8"x36" rered with aluminum Ogemaw county remon. cap.
Witnesses:
N50E 121.28 NW corner foundation of attached garage
S73W 60.34 spike in NW face of 12" Ash
N26W 52.54 spike in NE face of Utility pole
S39E 58.19 nail in SW face of corner post
EAST 1.98 G-13, T22N, R1E

Approved by Peer Review

12/15/98 DATE INITIALS

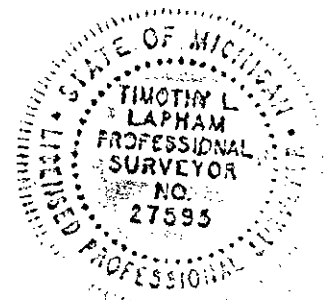

Signed by [Signature]
Surveyor's Michigan License No. 27595

Date 12/23/98